

Name Howard Daller

Service No. 411

Address 168 Burlington Street
Lexington, Mass.

Location 168 Burlington Street

Kind of Pipe Cor. June 21, 1948

Size

Size of Main

~~Repair/ Renewal~~ - New Service

Location

Date	Material	Amount	Total	Date	Amount
May 19, '48	Labor	2 15	2 15	May 15 '48	40 00
	10% Overhead		22	June 24 '48	2 28
	75' - 3/4" Copper Tubing @ .255	19 13	19 13		37 92
	1 - 3/4" C x 1/2" I.W.H. S & W	3 15	3 15	May 19, '48	4 25
	1 - 3/4" C x 3/4" C Union (3pts)	1 32	1 32	20' - 3/4" Copper Tubing @ .255	5 10
	Trucking 1 hr. @ .75	75	75	1 - 3/4" C Corp-cock	3 00
	Patching 11 x 3	11 00	11 00	1 - 3/4" C x 3/4" C Curb-cock	3 68
			37 72	1 - Box & Rod	3 50
	Trench dug by owner			1 - 1/2" Offset Tail Piece	30
				1 - 1/2" Straight Tail Piece	30
				Littlefield Shovel 2 hrs. @ 7.00	14 00
	Labor			Trucking 1 hr. @ .75	75
					34 88

Deposited
Refunded
Non-Charge

Hadley Press, Inc., Lexington

DATE _____

TOWN OF LEXINGTON—BOARD OF PUBLIC WORKS

WATER DIVISION

The undersigned applies for a supply of water at No. _____ St. and hereby agrees to comply with the rules and regulations as now, or at any future time, established by the Board of Selectmen.

Am't. of Estimate \$ _____


Owner _____

Am't. Paid \$ _____

Address _____

Builder _____

Sketch of Service Here

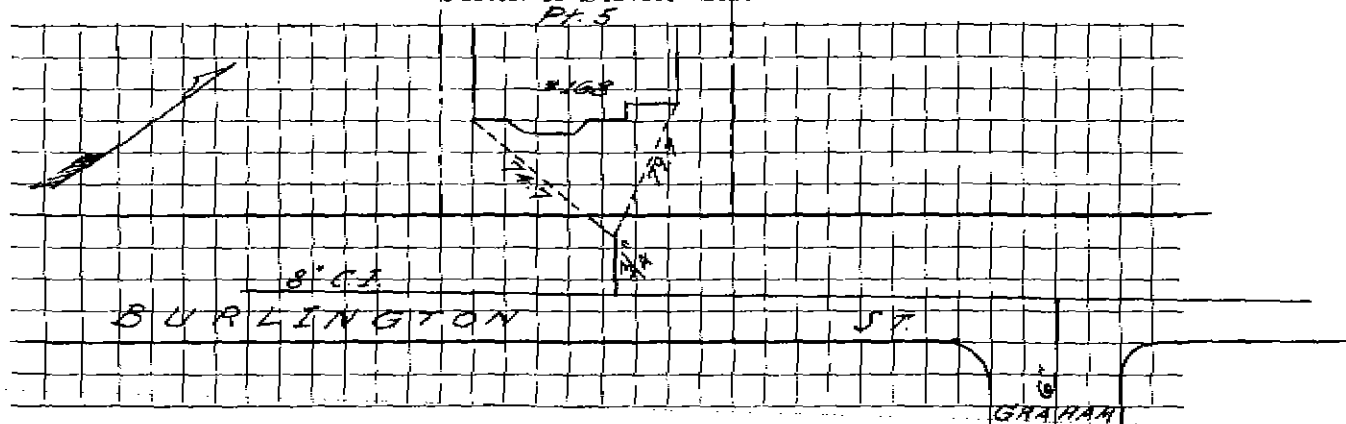

Connection made in _____ Street.

Work completed _____ 19

Remarks:

GRAHAM
A.D.