

WATER SERVICE RECORD

Name

Service No.

Address #17 BURLINGTON ST.

Location

Repair—Renewal—New Service WATER MAIN REPLACEMENT


Date	Material	Amount	Total	Date	Amount
9/16	92 19 LF 1" COPPER 1" CORD C/C & BOX 3/4" x 1" REDUCER UNION				
					INSIDE 1 49
				12/10/51	labor 15
					1076 OH
					45' 3/4" Copper Tubing @ 52¢ 14 67
					1 3/4" x 1/2" IWH 5¢ @ 4 00
					1 hr Trucking 75
					<u>21 06</u>

DATE 9/16/92

TOWN OF LEXINGTON — BOARD OF PUBLIC WORKS

WATER DIVISION

Sketch of Service Here

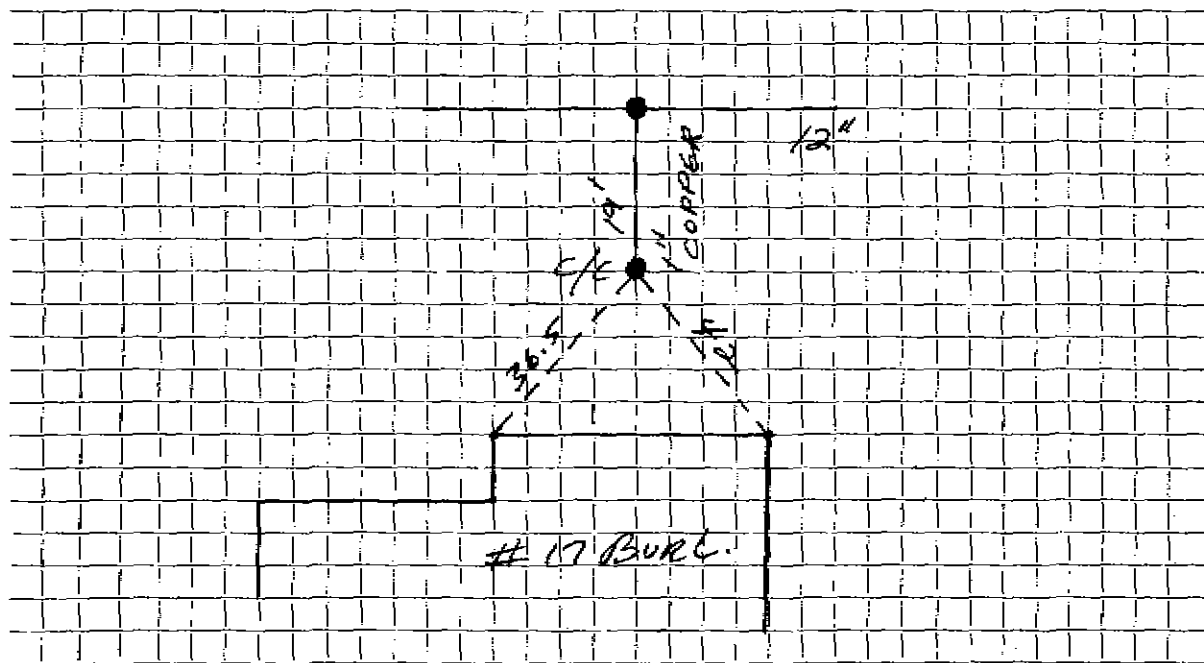

Connection made in # 17 BURLINGTON Street. Work completed BY: C. J. P.

Remarks: PART OF CONTRACT # 91-10, WATER MAIN REPLACE