

WATER SERVICE RECORD

Name Mildred Marano

Service No. 197

Address 171 Burlington Street

# 2458

Location Lexington, Mass.

~~Repair - Rework~~ New Service


COM.10-15-51

Date	Material	Amount	Total	Date	Amount
9-21-51	Labor	4 14	4 14	8-18-51 Deposited	15 00
	10% Overhead		41	10-15-51 Refunded	7 64
	90'-3/4" Copper Tubing @ .320		29 34	No Charge	67 36
	1-3/4" Cx 1/2" I.W.H. S&W		4 00	9-21-51 Labor	4 14
	1-3/4" Cx 3/4" C Union (3 pts)		1 72	8'-3/4" Copper Tubing	2 61
	3 Hr. Littlefield Shovel		21 00	1-3/4" C Corp-Cock	4 33
	1 Hr. Trucking		75	1-3/4" Cx 3/4" C Curb-Cock	4 67
	Patching 6x3		6 00	1-Box & Rod	4 68
			67 36	1-1/2 Offset tail piece	50
				1-1/2 straight tail piece	50
				1 Hr. Littlefield Shovel	7 00
				1 Hr. Trucking	75
					<u>29 18</u>

DATE \_\_\_\_\_

**TOWN OF LEXINGTON — BOARD OF PUBLIC WORKS**  
**WATER DIVISION**

Sketch of Service Here

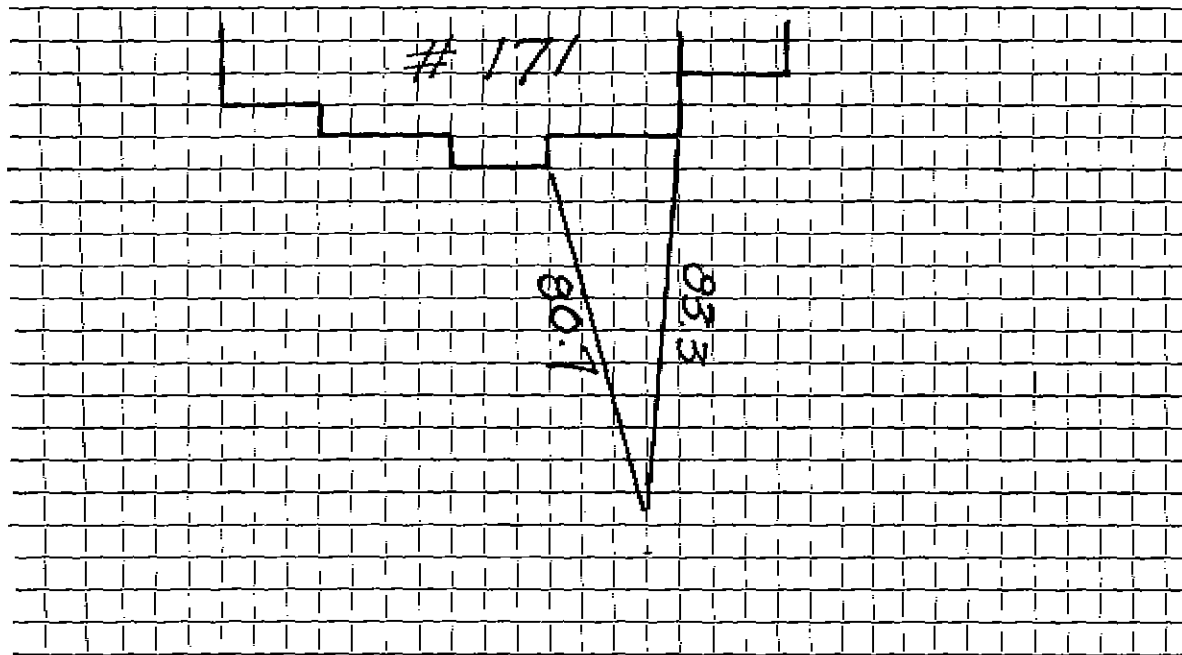

Connection made in ..... Street. Work completed .....

Remarks: .....

.....

.....