

Name Frederick J. Hopwood

Service No. 92-2833

Address 172 Burlington Street

Lexington, Mass.

Location 172 Burlington Street

Kind of Pipe

Size

Size of Main

Repair - Renewal - New Service

Com. 8-23-48

Location

Date	Material	Amount	Total	Date	Amount
June 23, '48	Labor	2 10	2 10	June 12 '48	55 00
	10% Overhead		21	July 20 '48	13 22
	86' - 3/4" Copper Tubing @ .255	21 93	21 93		41 78
	1 - 3/4" C x 1/2" I.W.H. S & W	3 15	3 15	June 23, '48	5 95
	2 - 3/4" C x 3/4" C Unions (3 pts)	2 64	2 64	18' - 3/4" Copper Tubing @ .255	4 59
	Trucking 1 hr. @ .75	75	75	1 - 3/4" C Corp-cock	3 00
	Patching 11 x 3		11 00	1 - 3/4" C x 3/4" C Curb-cock	3 68
			41 78	1 - Box & Rod	3 55
	Trench dug by owner.			1 - 1/2" Offset Tail Piece	30
				1 - 1/2" Straight Tail Piece	30
				Littlefield Shovel 2 1/2 hrs. @ 7.00	17 50
	Labor			Trucking 1 hr. @ .75	75
					39 62

Hadley Press, Inc., Lexington

DATE \_\_\_\_\_

# TOWN OF LEXINGTON—BOARD OF PUBLIC WORKS

## WATER DIVISION

The undersigned applies for a supply of water at No. \_\_\_\_\_ St. and hereby agrees to comply with the rules and regulations as now, or at any future time, established by the Board of Selectmen.

Am't. of Estimate \$ \_\_\_\_\_

Owner \_\_\_\_\_


Am't. Paid \$ \_\_\_\_\_

Address \_\_\_\_\_

Builder \_\_\_\_\_

*181 Charlesbank St. Boston Mass*

Sketch of Service Here

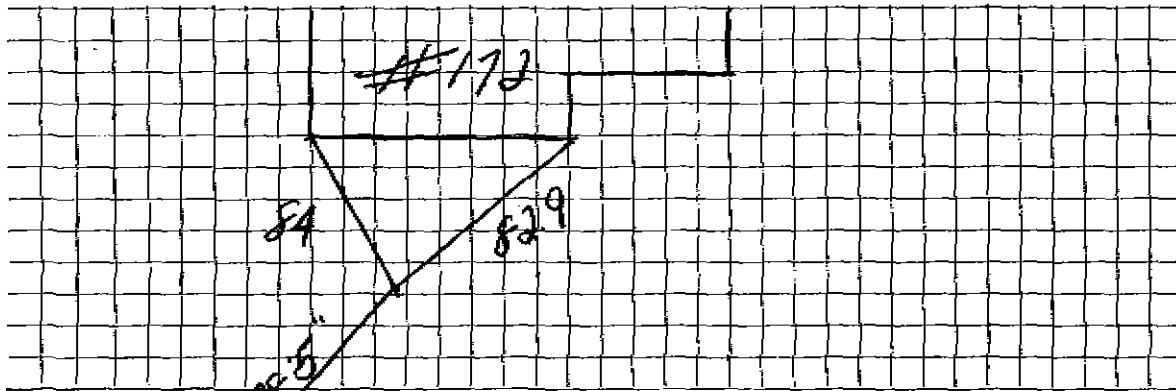

Connection made in \_\_\_\_\_ Street. Work completed \_\_\_\_\_ 19\_\_\_\_

Remarks: