

WATER SERVICE RECORD

#6528

Name John Arno

Service No. 19

Address 177 Burlington St.

Location Lexington

REPAIR WORK - New Service

COM. 2-16-53


Date	Material	Amount	Total	Date	Amount
1/27/53	Labor	8 82		1-26-53	Deposited 60 00
	10% overhead	88	9 70	2-16-53	Refunded (4) 27
	42'-3/4" Copper tubing @ .34		14 28		NON CHARGE 53 73
	1-3/4" Cx 1/8 I.W.H. stop & Waste		4 00	1/27/53	Labor 8 82
	3 Hr. Littlefield Shovel		21 00		8'-3/4" Copper Tubing @ .34 2 72
	1 Hr. Trucking		75		1-3/4" C. Copp-cock 4 33
	Patching 6 x 3		6 00		1-3/4" Cx 3/4" C. Curb-cock 4 67
			55 73		1-Box & Rod 3 90
					1-1/2 offset Tail Piece 50
					1-1/2 straight Tail Piece 50
					1 Hr. Littlefield Shovel 7 00
					1 Hr. Trucking 75
					33 19

DATE _____

TOWN OF LEXINGTON — BOARD OF PUBLIC WORKS

WATER DIVISION

Sketch of Service Here

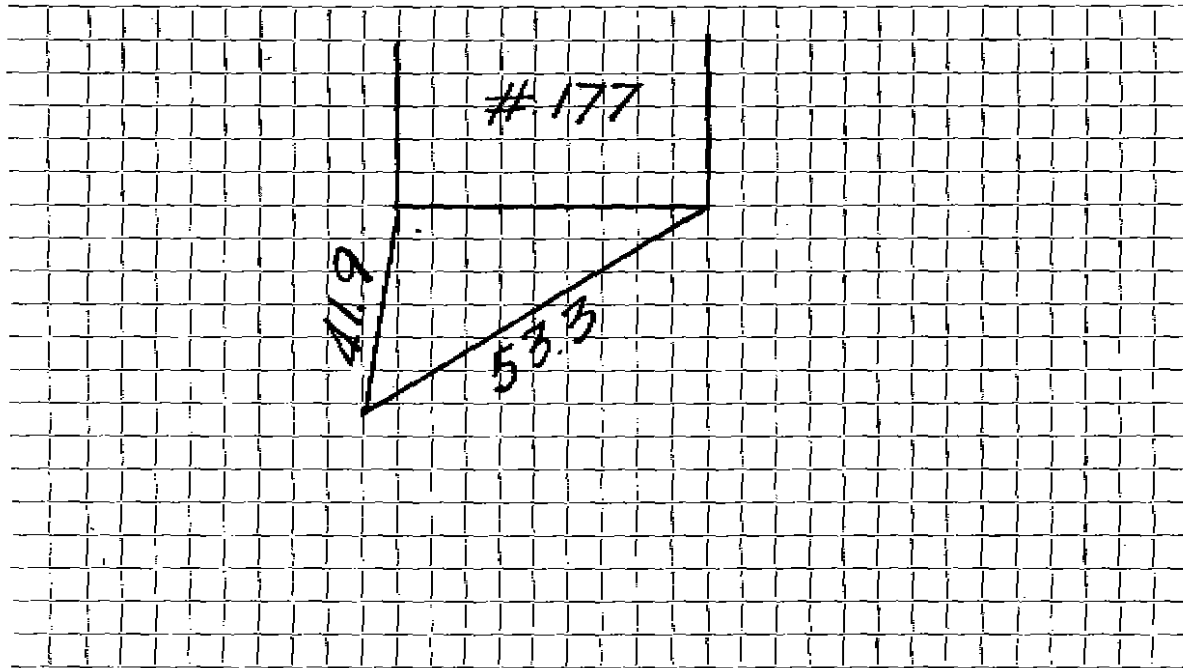

Connection made in _____ Street. Work completed _____

Remarks: _____
