


Date: 6/8/2023

TOWN OF LEXINGTON - BOARD OF PUBLIC WORKS
SEWER DIVISION

SKETCH OF SERVICE HERE

Water ties

- 1-B = 13'
- 2-B = 64'
- 4-A = 8.7'
- B-W = 2.3'

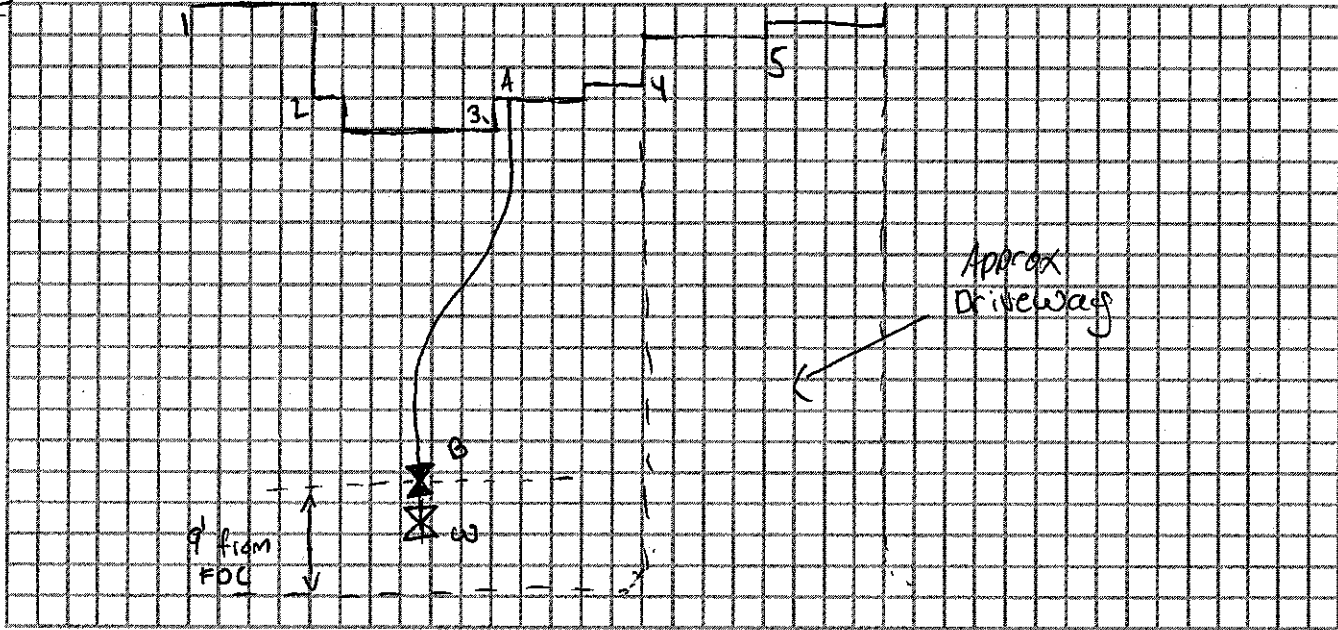

- Description
- 1 - outside corner House
 - 2 - corner
 - 3 - corner
 - 4 - corner
 - 5 - right corner House
 - A = 1" copper water service
 - B = 1" curb valve

Connection made in: _____ Street. Work completed: _____

Remarks: Installed by Frank Delveira & son inc.