

WATER SERVICE RECORD

Name Frances Nestico

Service No. 162

Address 184 Burlington Street

Location Lexington, Mass.

Repair/Replacement—New Service *Com. 10-1-51*


Date	Material	Amount	Total	Date	Material	Amount
8/6/51	Labor	1 49	1 49	7-12-51	<i>Deposited</i>	50 00
	10% overhead		15	10-1-51	<i>Refunded</i>	16 20
	35' -3/4" copper tubing @ .326		11 41		<u>No Charge</u>	33 20
	1 -3/4" Cx $\frac{1}{8}$ " I.W.H. stop&waste		4 00	8/6/51	Labor	6 79
	1 hr. trucking		75		24' -3/4" copper tubing @ .326	7 82
	patching 16x3		16 00		1 -3/4" C. corp-cock	4 33
			33 80		1 -3/4" Cx3/4" C curb-cock	4 67
	TRENCH DUG BY OWNER				1 box and rod	4 68
					1 $\frac{1}{8}$ " straight tail piece	50
					1 $\frac{1}{8}$ " offset tail piece	50
					3 hrs. Littlefield shovel	21 00
					1 hr. trucking	75
						51 04

DATE \_\_\_\_\_

TOWN OF LEXINGTON — BOARD OF PUBLIC WORKS

WATER DIVISION

Sketch of Service Here

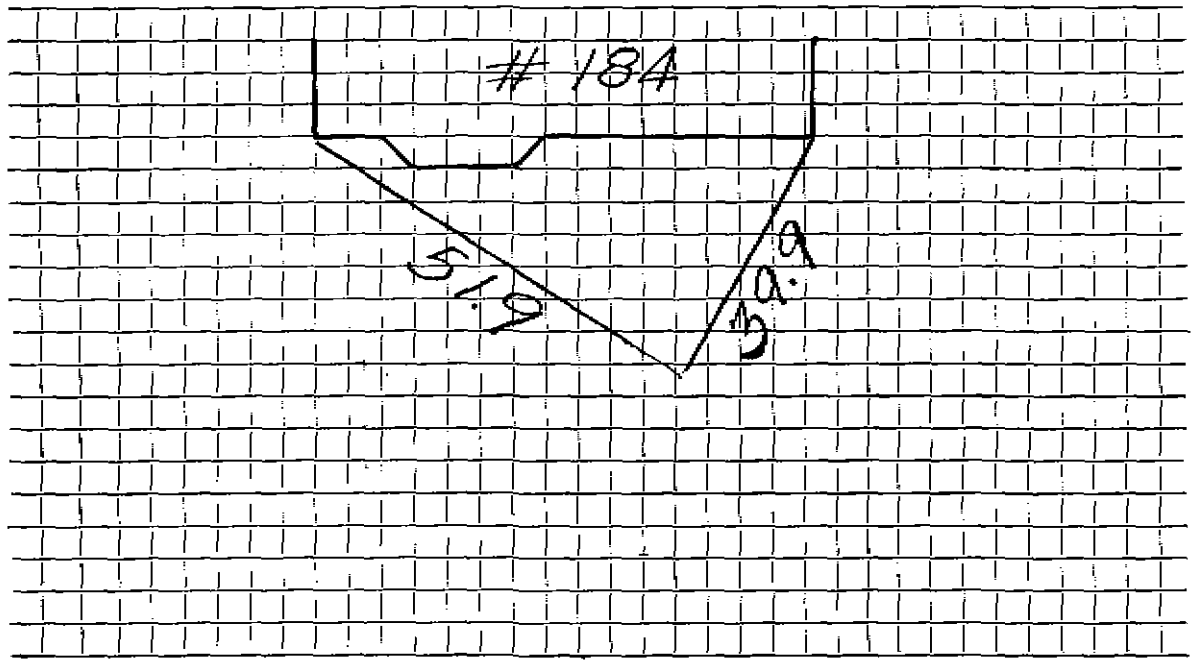

Connection made in ..... Street. Work completed .....

Remarks: .....  
.....  
.....