

Name Peter Helburn
 Address 185 Burlington Street
 Lexington, Mass.

Service No. 8292
 # 2286
 # 6625

Location 185 Burlington St.

Kind of Pipe

Size

Size of Main

~~Repair~~ ~~Renewal~~ ~~New Service~~

Location

Date	Material	Amount	Total	Date	Amount
June 26, '47	Labor	1 05	1 05	June 26, '47	15 00
	10% Overhead		11	Sept 25, '47	3 19
	25' - 3/4" Copper Tubing @.27	6 75	6 75		11 81
	1 - 3/4" C x 1/8" I.W.H. S & W	3 15	3 15	June 26, '47	1 05
	Trucking 1 hr. @.75	75	75	9' - 3/4" Copper Tubing @.27	2 43
			11 81	1 - 3/4" C Corp-cock	3 00
				1 - 3/4" C x 3/4" C Curb-cock	3 68
				1 - Box & Rod	4 26
				1 - 1/2" Straight Tail Piece	30
				1 - 1/2" Offset Tail Piece	30
				Trucking 1 hr. @.75	75
	Labor				15 77

Deposited
Refunded
 Non-Charge

Madley Press, Inc., Lexington

DATE _____

TOWN OF LEXINGTON—BOARD OF PUBLIC WORKS

WATER DIVISION

The undersigned applies for a supply of water at No. _____ St. and hereby agrees to comply with the rules and regulations as now, or at any future time, established by the Board of Selectmen.

Am't. of Estimate \$ _____


Owner _____

Am't. Paid \$ _____

Address _____

Builder _____

Sketch of Service Here

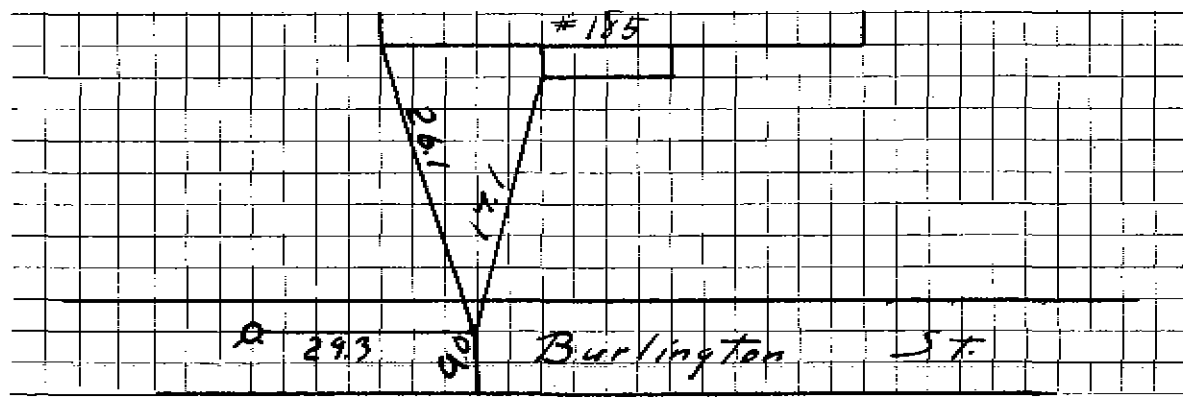

Connection made in _____ Street.

Work completed _____ 19

Remarks: