

WATER SERVICE RECORD

Name Russell Hulbert

Service No. 7

Address 188 Burlington Street

#3978 #5488

Location Lexington, Mass.

#7035

~~Repair~~ ~~Renewal~~ New Service


Com. 2-19-51

Date	Material	Amount	Total	Date	Amount	
1-17-51	Labor	2 60	2 60	<i>George 51</i>	<i>Reported</i>	<i>53 00</i>
	10% Overhead		26	<i>Feb 27 51</i>	<i>Card</i>	<i>1 57</i>
	86' - 3/4" Copper Tubing @.34		29 24		No Charge	<i>56 57</i>
	1 - 3/4" C x 1/2" I.W.H. S&W		4 00	1-17-51	Labor	7 80
	1 - 3/4" C x 3/4" Union (3pts)		1 72		30' - 3/4" Copper Tubing @.34	10 20
	Trucking 1 hr. @.75		75		1 - 3/4" C Corp-cock	4 33
	Patching 18 x 3		18 00		1 - 3/4" C x 3/4" Curb-cock	4 67
			56 57		1 - Box & Rod	3 90
					1 - 1/2" Offset Tail Piece	50
					1 - 1/2" Straight Tail Piece	50
					Littlefield Shovel 4 hrs. @7.00	28 00
					Trucking 1 hr. @.75	75
						60 65

DATE _____

TOWN OF LEXINGTON — BOARD OF PUBLIC WORKS
WATER DIVISION

Sketch of Service Here

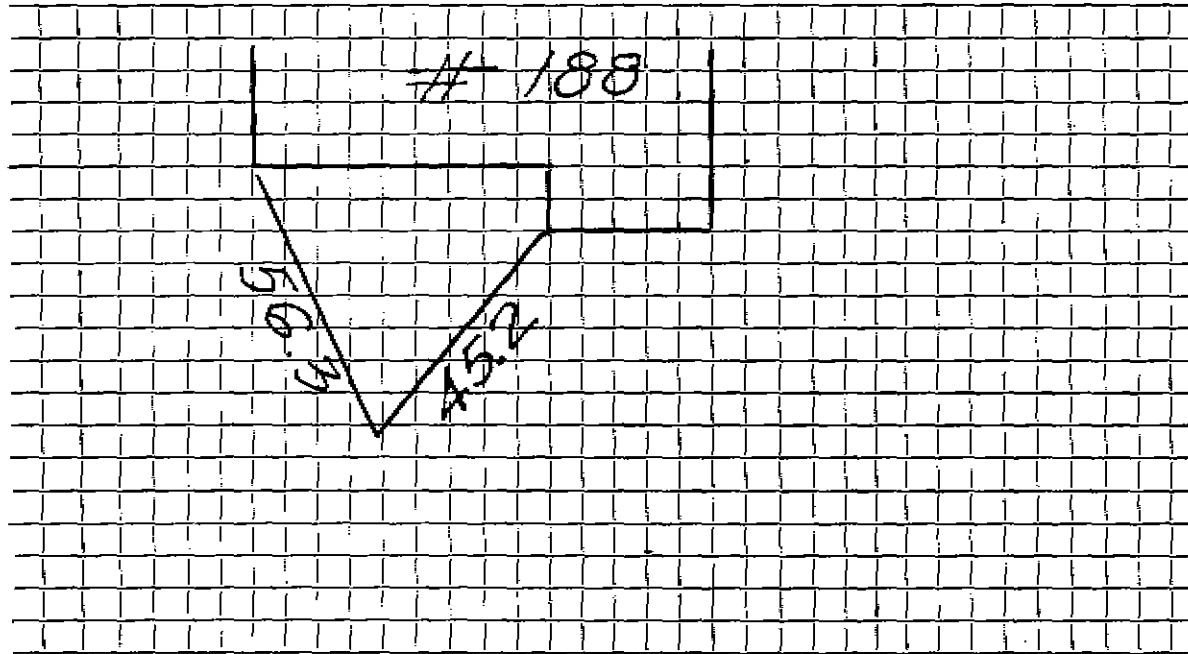

Connection made in Street. Work completed

Remarks:

.....

.....