

WATER SERVICE RECORD

#4320

Name C. Courtney Comeau

Service No. 24

Address 189 Burlington Street

Location Lexington, Mass.


~~Repair~~ ~~Renewal~~ New Service Com. 5-21-51

Date	Material	Amount	Total	Date	Material	Amount
3-14-51	Labor	4 85	4 85	May 6 1951	Repaired	45 00
	10% Overhead		49	May 24 1951		2 51
	35' - 3/4" Copper Tubing @ .36	12 60	12 60		No Charge	42 69
	1 - 3/4" C x 1/2" I.W.H. S&W		4 00	3-14-51	Labor	4 85
	Trucking 1 hr. @ .75		75		12' - 3/4" Copper Tubing @ .36	4 32
	Patching 6 x 3		6 00		1 - 3/4" C Corp-cock	4 33
			42 69		1 - 3/4" C x 3/4" C Curb-cock	4 67
					1 - Box & Rod	4 68
					1 - 1/2" Offset Tail Piece	50
					1 - 1/2" Straight Tail Piece	50
					Littlefield Shovel 1 hr. @ 7.00	7 00
					Trucking 1 hr. @ .75	75
						31 60

DATE \_\_\_\_\_

**TOWN OF LEXINGTON — BOARD OF PUBLIC WORKS**  
**WATER DIVISION**

Sketch of Service Here

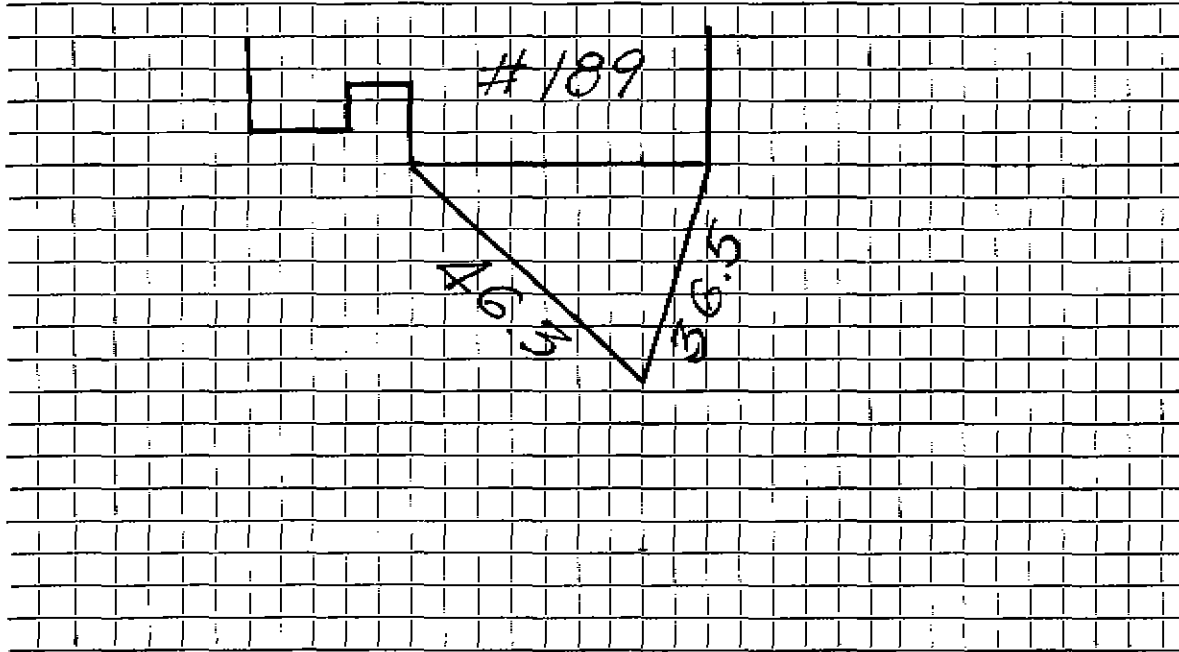

Connection made in ..... Street. Work completed .....

Remarks: .....

.....  
.....