

WATER SERVICE RECORD

Name Lyle Shufelt

Service No. 54

Address 192 Burlington St.

# 2845

Location Lexington

Repair ~~XXXXXX~~ - New Service COM. 5-18-53

Date	Material	Amount	Total	Date	Amount	
4-15/53	Labor	1 75		3-16-53	75 00	
	10% overhead	18	1 93	5-18-53	25 62	
	55'-3/4" Copper tubing @.34		18 70		49 38	
	1-3/4" C x 1/2 I.W.H. stop & waste		4 00	4/15/53	Labor	29 50
	1 Hr. Trucking		75		30'-3/4" Copper Tubing @.34	10 20
	Patching 2 1/2 x 3		24 00		1-3/4" C. Corp-cock	4 33
			49 38		1-3/4" C x 3/4 C. Curb-cock	4 67
	TRENCH DUG BY OWNER				1-Box & Rod	3 90
					1-1/2 Straight Tail Piece	50
					1-1/2 offset tail piece	50
					5 Hr. Littlefield Shovel	7.50
					1 Hr. Trucking	75
						91 85


*Deposited*  
*Refunded*  
NON\*CHARGE

DATE \_\_\_\_\_

TOWN OF LEXINGTON — BOARD OF PUBLIC WORKS

**WATER DIVISION**

Sketch of Service Here

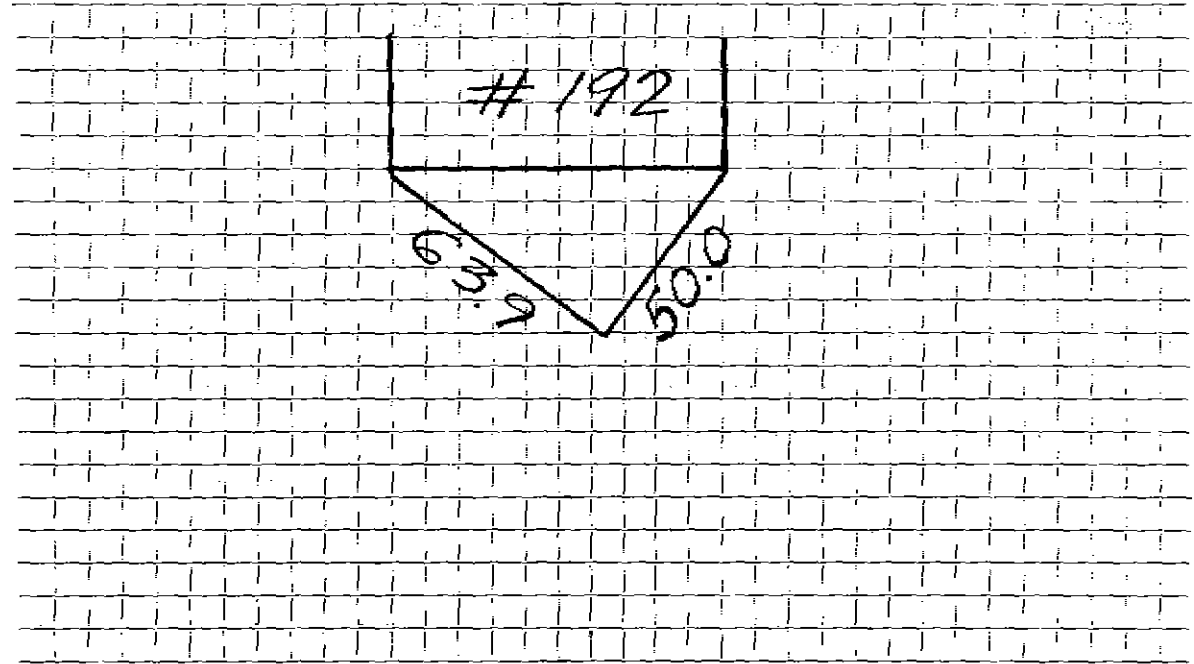

Connection made in ..... Street. Work completed .....

Remarks: .....  
.....  
.....