

Name C. Courtney Comeau
 Address 193 Burlington Street
 Lexington, Mass.

Service No. 185 #6281

Location 193 Burlington Street

Kind of Pipe Size Size of Main

~~Repair x Renewal~~ - New Service

Com. 11-6-50

Location

Date	Material	Amount	Total	Date	Amount
Aug. 7, '50	Labor	2 55	2 55	July 25 '50	60 00
	10% Overhead		26	Deposited	11 11
	47' - 3/4" Copper Tubing @.23	10 81	10 81	No Charge	43 66
	1 - 3/4" C x 1/2" I.W.H. S&W	3 29	3 29	Aug. 7, '50	3 42
	Littlefield Shovel 3 hrs. @ 7.00	21 00	21 00	10' - 3/4" Copper Tubing @.23	2 30
	Trucking 1 hr. @.75	75	75	1 - 3/4" C Corp-cock	3 15
	Patching 7 x 3	7 00	7 00	1 - 3/4" C x 3/4" C Curb-cock	3 85
			45 66	1 - Box & Rod	3 35
				1 - 1/2" Offset Tail Piece	42
				1 - 1/2" Straight Tail Piece	42
				Littlefield Shovel 1 hr. @ 7.00	7 00
				Trucking 1 hr. @.75	75
	Labor				24 66

Hadley Press, Inc., Lexington

DATE _____

TOWN OF LEXINGTON—BOARD OF PUBLIC WORKS

WATER DIVISION

The undersigned applies for a supply of water at No. _____ St. and hereby agrees to comply with the rules and regulations as now, or at any future time, established by the Board of Selectmen.

Am't. of Estimate \$ _____


Owner _____

Am't. Paid \$ _____

Address _____

Builder _____

Sketch of Service Here

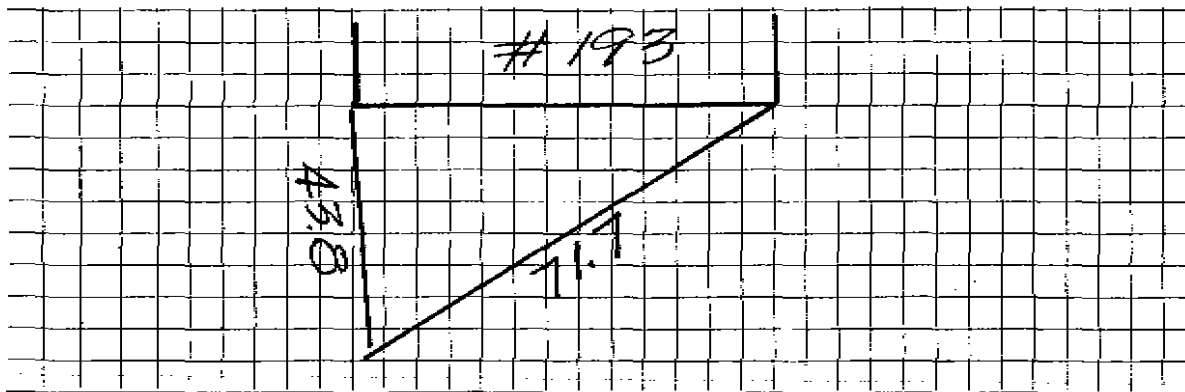

Connection made in _____ Street.

Work completed _____ 19

Remarks: