


DATE _____

TOWN OF LEXINGTON — BOARD OF PUBLIC WORKS
WATER DIVISION

Sketch of Service Here

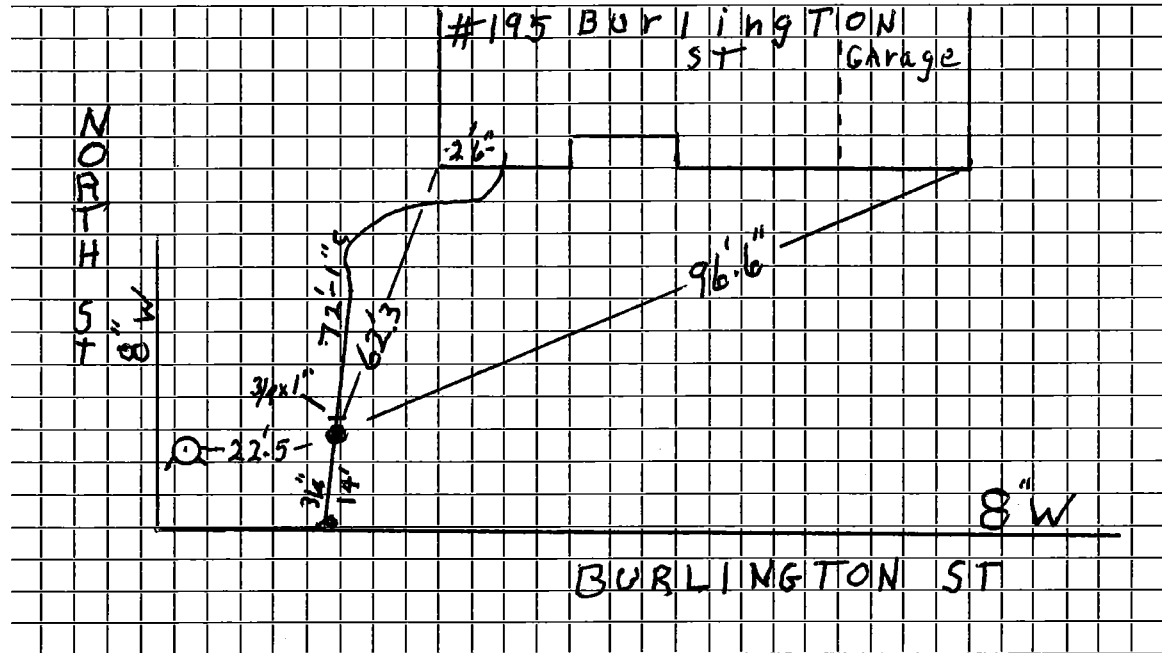

Connection made in Burlington S.T. Street.

Work completed 12/10/10 J. McLaughlin

Remarks:

.....

.....