


DATE 7-9-02

TOWN OF LEXINGTON — BOARD OF PUBLIC WORKS
WATER DIVISION

Sketch of Service Here

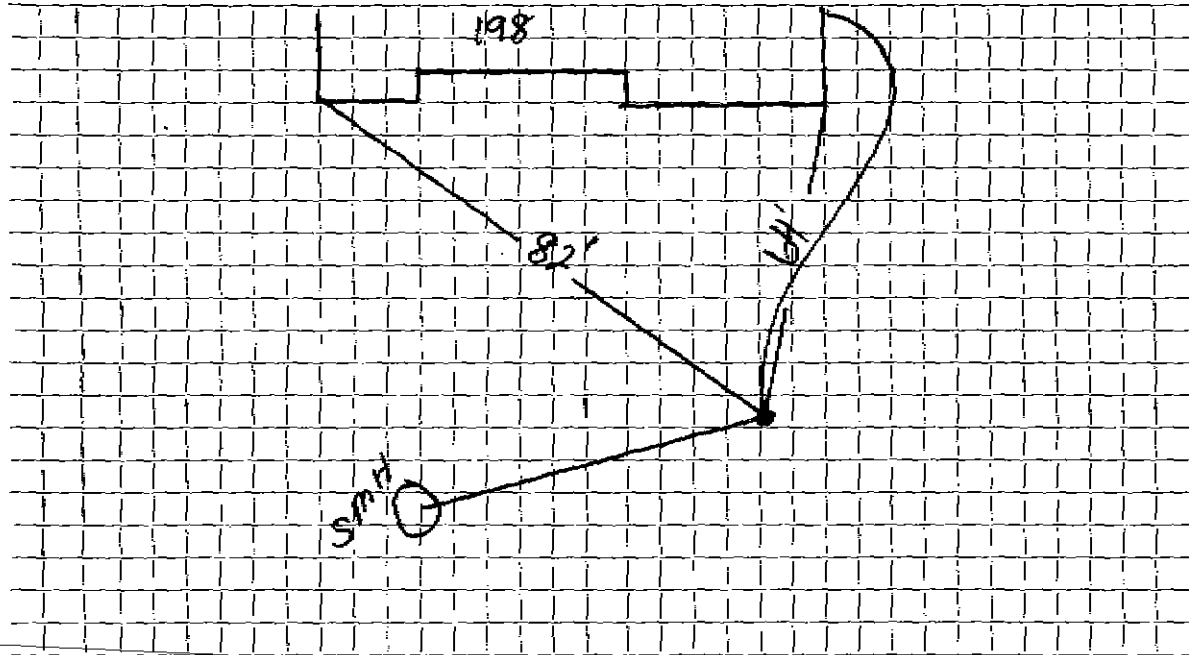

Connection made in Street.

Work completed 7-8-02


Remarks:
.....
.....

DATE 10-23-01

TOWN OF LEXINGTON — BOARD OF PUBLIC WORKS

WATER DIVISION

Sketch of Service Here

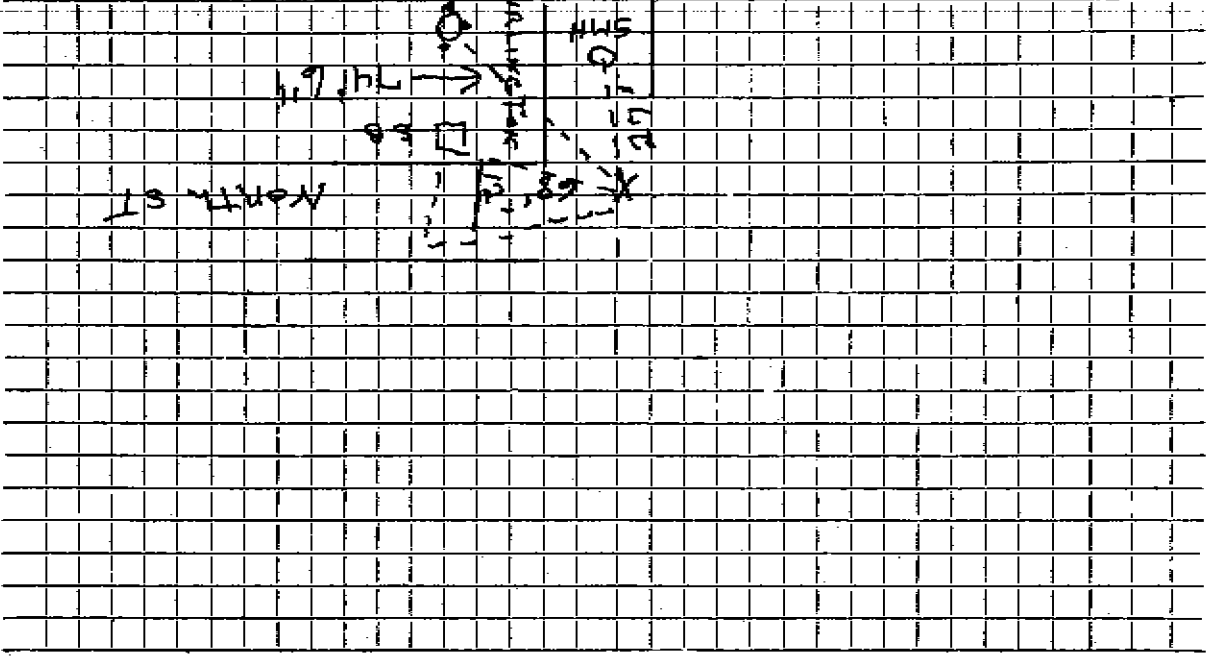

Main 5.6"
Curb 4.6"

Work completed

Street

North St

Connection made in North St
Remarks: Installed by S.S. 10051