

WATER SERVICE RECORD

960

Name Charles Zaccaria

Service No. 168

Address 20 Burlington Street

Location

~~Repair - Renewal~~ - New Service

C. Zaccaria


Date	Material	Amount	Total	Date	Material	Amount
9-28-60	Labor	1.94		8-14-60	Deposit	50.00
	10% O.H.	.19	2.13	10-24-60	Refund	19.44
	53' 3/4" Copper tubing @.42	22.26	22.26			30.56
	1 3/4" C x 1/2 I.M.H. Stop & Waste	6.17	6.17		NON CHARGE	
			30.56	9-28-60	Labor	1.94
					20' 3/4" Copper tubing @.42	8.40
					1 3/4" C Carb Cock	6.28
					1 3/4" C Corp Cock	4.91
					1 Box & Rod	4.90
					1 1/2" Straight tailpiece	.50
					1 1/2" Offset tailpiece	.50
						27.43

DATE _____

TOWN OF LEXINGTON — BOARD OF PUBLIC WORKS

WATER DIVISION

Sketch of Service Here

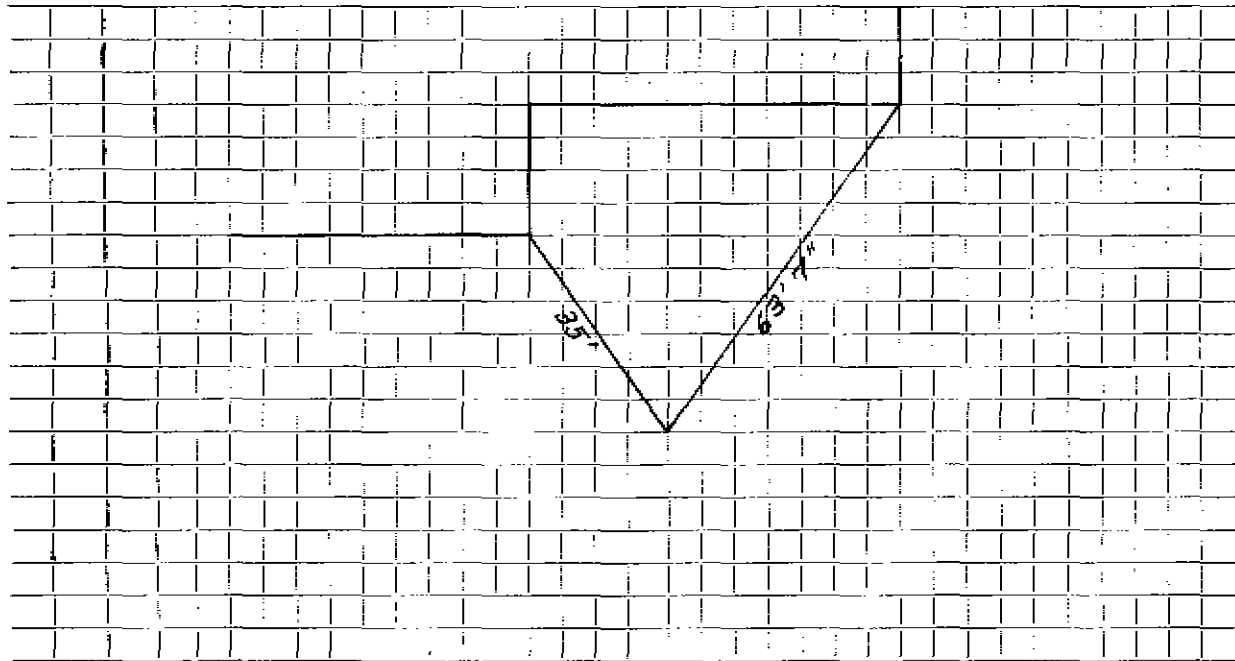

Connection made in Street. Work completed

Remarks:

.....

.....