


DATE 9/92

TOWN OF LEXINGTON — BOARD OF PUBLIC WORKS
WATER DIVISION

Sketch of Service Here

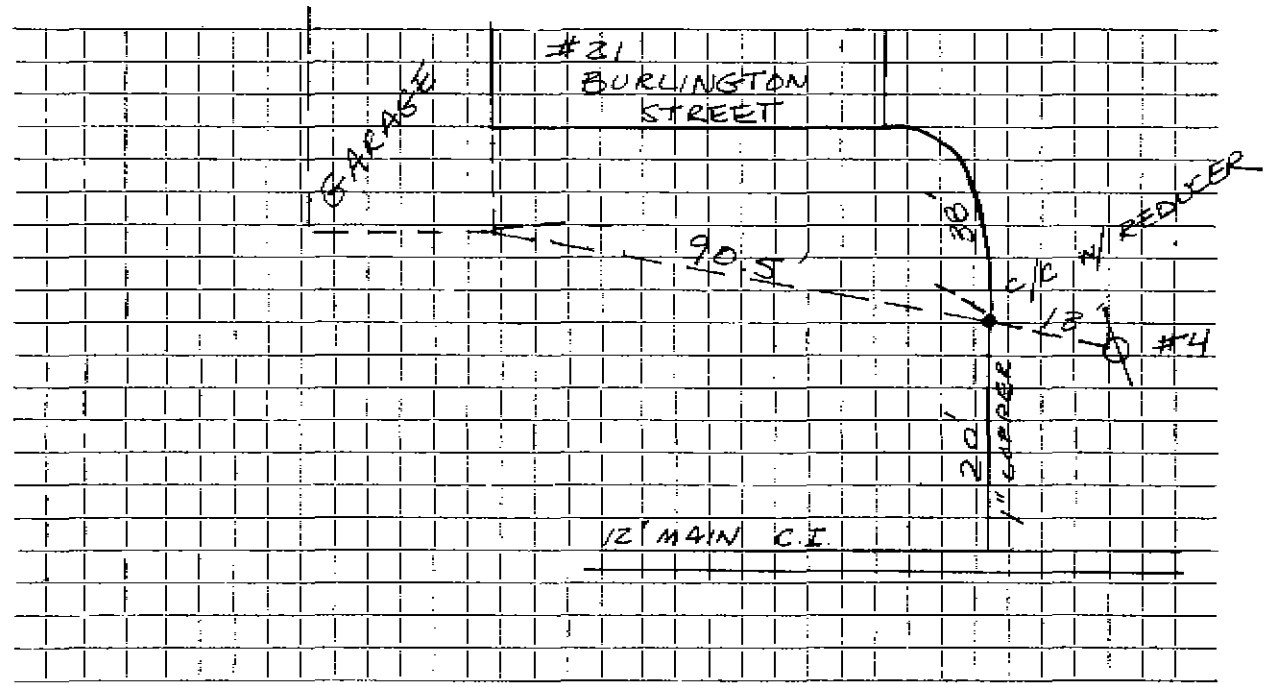

Connection made in BURLINGTON Street. Work completed BY C.J.P.

Remarks: CONTRACT # 91-10 FOR OUTSIDE WORK