




DATE 9/16/92

TOWN OF LEXINGTON — BOARD OF PUBLIC WORKS

WATER DIVISION

Sketch of Service Here

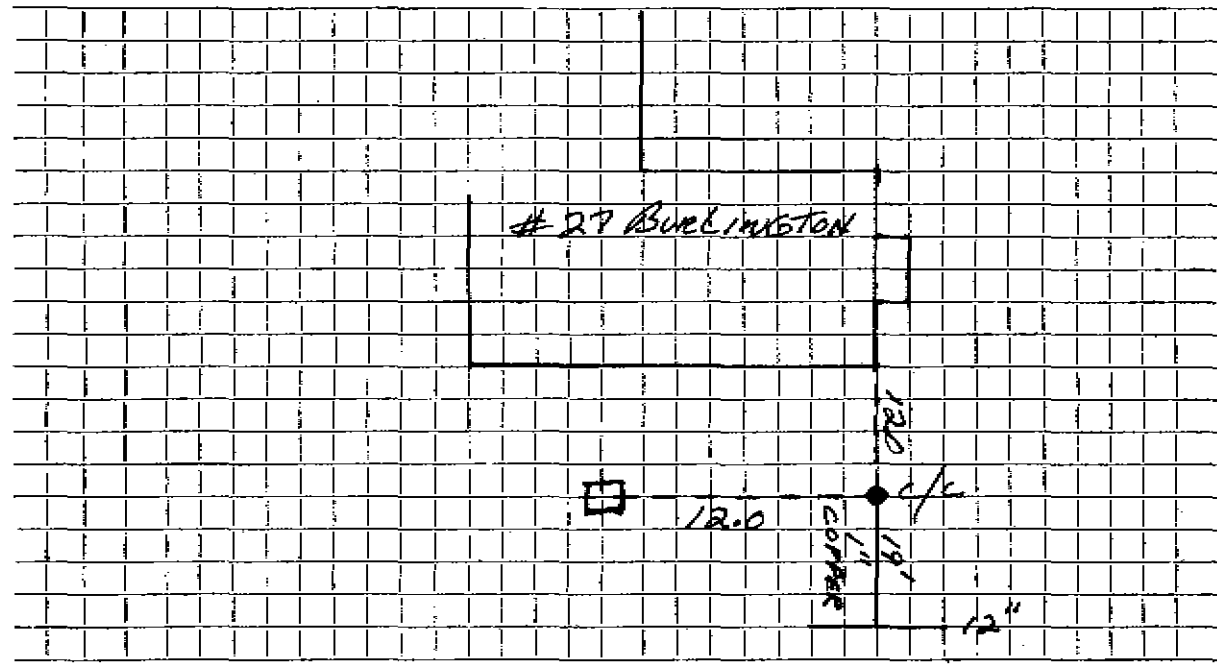

Connection made in # 27 BURLINGTON Street. Work completed BY: C. J. P.

Remarks: PART OF CONTRACT # 91-10 WATER MAIN REPLACE