




DATE 9/16/92

TOWN OF LEXINGTON — BOARD OF PUBLIC WORKS

WATER DIVISION

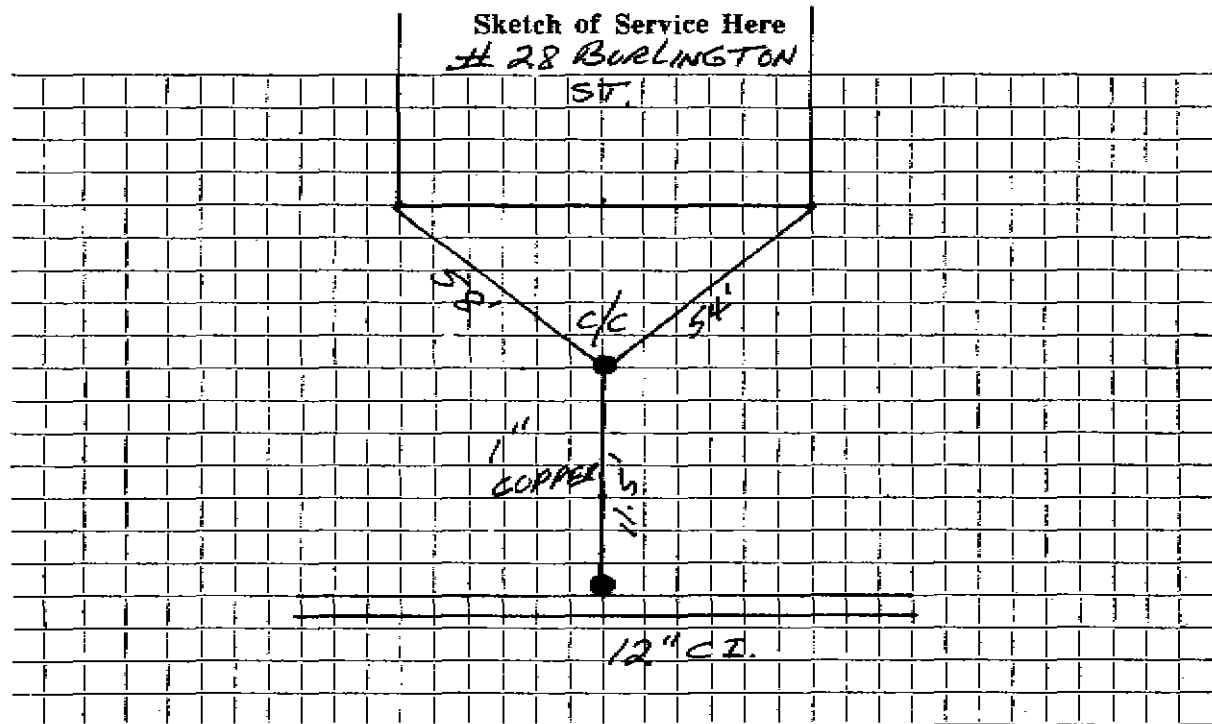

Connection made in # 28 BURLINGTON Street. Work completed BY: G. J. P.

Remarks: CONTRACT # 91-10 WATER MAIN REPLACE