

WATER SERVICE RECORD

Name

Service No.

Address

30 Burlington St.

Location

~~Repair~~—Renewal—~~New Service~~ WO #4746


Date	Material	Amount	Total	Date	Material	Amount	Total
					OUTSIDE		
				7/29/76	labor	137.	52
					18' 3/4" copper @ .65	11.	70
					1 3/4" corp.	10.	53
					1 3/4" curb	13.	70
					1 1" clamp	5.	25
					1 1" X 3" iron nipple	.	70
					1 1" coupling	.	89
					2 tons coal patch @ 12.	25.	00
					6 yds. gravel @ 2.19	13.	14
					2½ tons hot top 14' X 5' X 3"	46.	68
					3/4 tons hot top 10'6" X 5' X 4"	33.	30
					1½ hr. trucking @ 3.00	4.	50
					3 hr. town shovel @ 6.50	19.	50
						322.	41

DATE _____

TOWN OF LEXINGTON — BOARD OF PUBLIC WORKS

WATER DIVISION

Sketch of Service Here

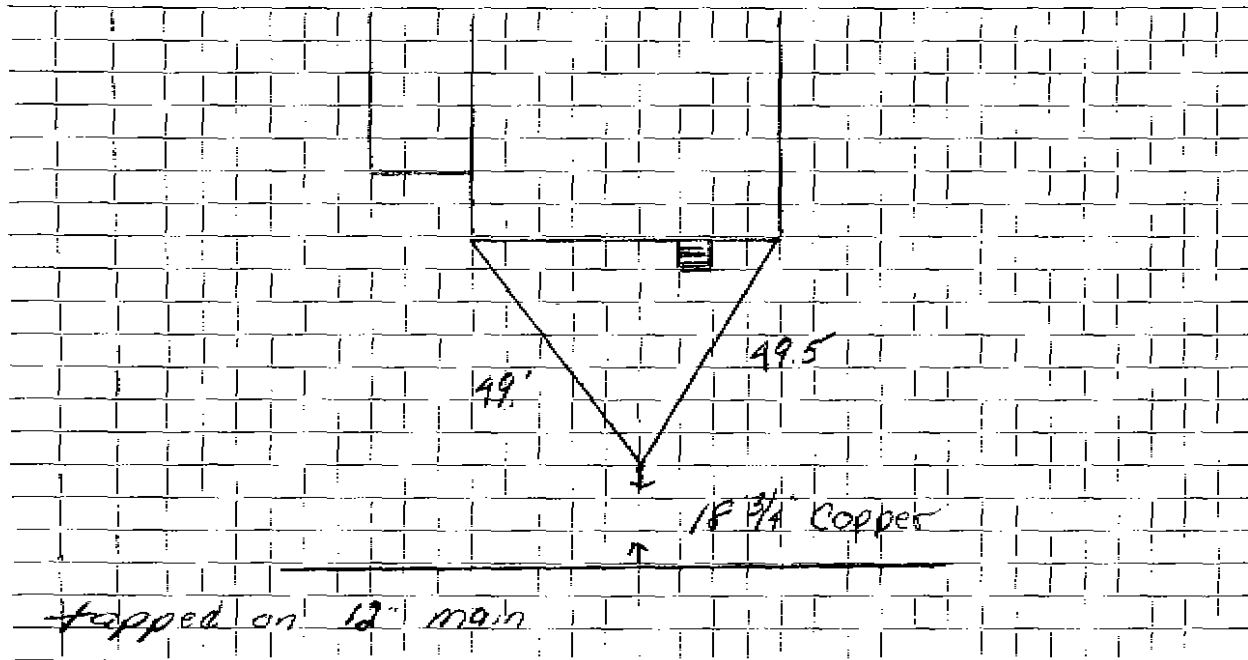

Connection made in Street. Work completed

Remarks:

.....

.....