

WATER SERVICE RECORD

Name

Service No.

Address 38 Burlington Street

Location Lexington, MA

Repair—~~Renewal~~—New Service *WATER MAIN REPLACEMENT*


Date		Material	Amount	Total	Date		Amount
8/14	48	Labor	1 25	1 25			
		10% Overhead		13			
		62' 3/4" Copper	@ .255	15 81	9/	92	OUTSIDE
		1-3/4" Cx1/2" I.W.H. S&W		3 15			15.5 LF 1" COPPER
		1-3/4" Cx3/4" C Union (3Pts)		1 32			C/C & BOX
				14 00			3/4"x1" UNION <i>REDUCER UNION</i>
				75			1" CORP.
				13 00			
				49 41			

DATE 9/92

TOWN OF LEXINGTON — BOARD OF PUBLIC WORKS

WATER DIVISION

Sketch of Service Here

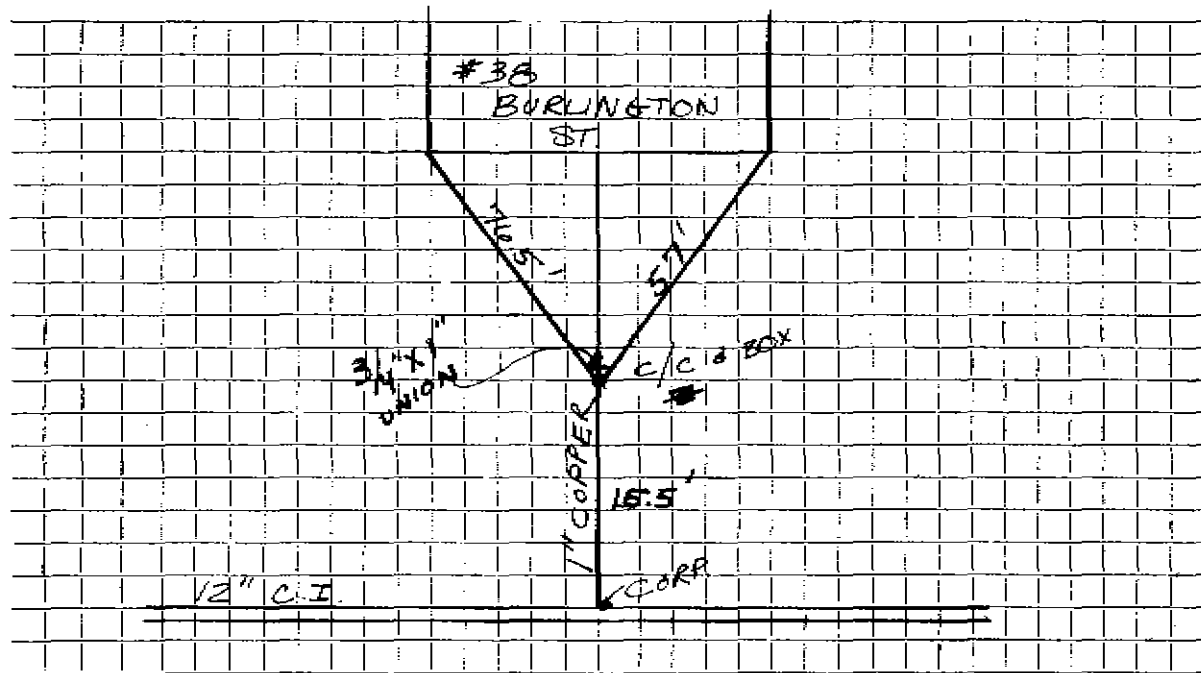

Connection made in BURLINGTON Street. Work completed BY C.J.P.

Remarks: CONTRACT # 91-10