




DATE 9/16/92

TOWN OF LEXINGTON — BOARD OF PUBLIC WORKS  
WATER DIVISION

Sketch of Service Here

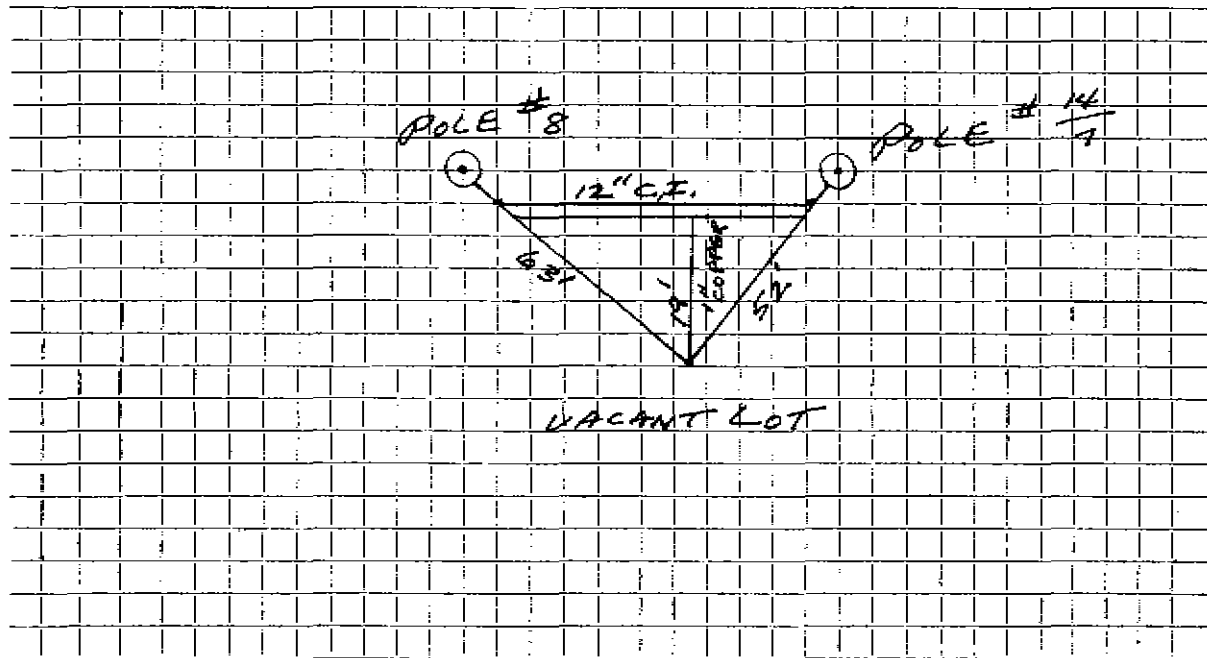

Connection made in BURLINGTON Street. Work completed .....

Remarks: PART OF CONTRACT # 91-10 "WATER MAIN REPLACE"  
INSTALLED BY: C.J.P.