

# WATER SERVICE RECORD

Name

Service No.

Address 45 BURLINGTON ST.

Location

Repair—Renewal—New Service WATER MAIN REPLACEMENT


Date	Material	Amount	Total	Date	Amount
12-5-91	53' 3/4" Copper 1 3/4" C X 1/2 S&W 1 3/4" Union 3 Part				
				10/92	<u>OUTSIDE:</u> 19 LF 1" COPPER C/C W/ BOX 1" CORP. 3/4" x 1" REDUCER

DATE 9/92

TOWN OF LEXINGTON — BOARD OF PUBLIC WORKS

WATER DIVISION

Sketch of Service Here

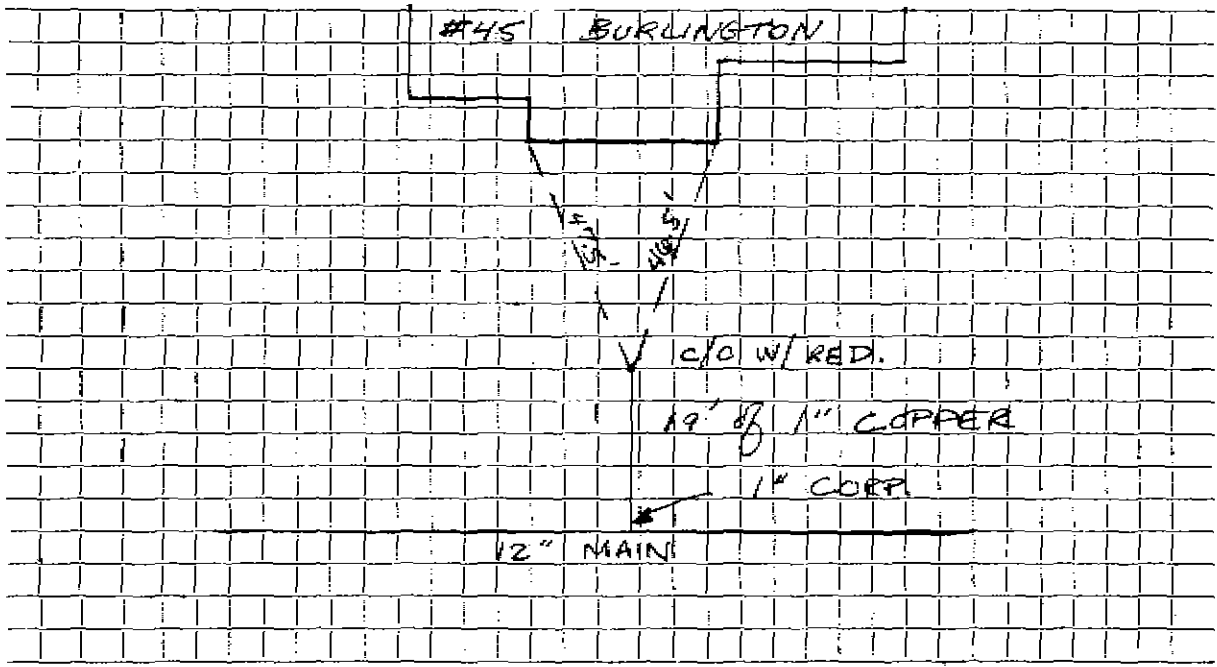

Connection made in BURLINGTON Street. Work completed BY: C.J.P.

Remarks: PART OF CONTRACT # 91-10 "WATER MAIN REPLACE"