

WATER SERVICE RECORD

Name

Service No.

Address # 46 BURLINGTON ST.

Location

Repair—Renewal—New Service WATER MAIN REPLACEMENT


Date	Material	Amount	Total	Date	Amount
7-21-48	Labor	4 40			
	10% O.H.	44	4 84		
42'	3/4" Copper Tubing @ 255		10 71	9/ 92	OUTSIDE: 15' of 1" COPPER
1	3/4" C x 1/2" I.D.H. 54W		3 15		c/c w/ BOX
1	3/4" C x 3/4" C Union 3 p/s		1 32		3/4" x 1" REDUCER
2	hr Littlefield Shovel		14 00		1" CORP.
1	hr Trucking		25		
	16 x 3 Patching		16 00		
			50 77		

DATE 9/92

TOWN OF LEXINGTON — BOARD OF PUBLIC WORKS

**WATER DIVISION**

Sketch of Service Here

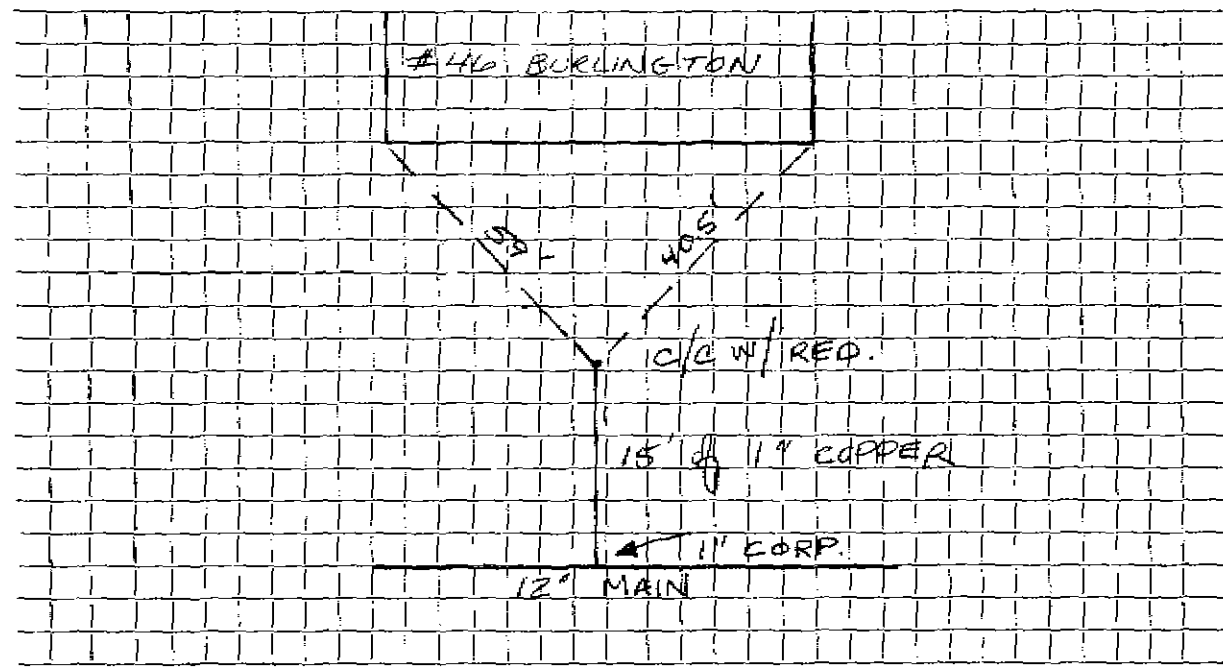

Connection made in BURLINGTON Street. Work completed BY: CJP

Remarks: PART OF CONTRACT # 91-10 "WATER MAIN REPLACE"