


DATE 9/92

TOWN OF LEXINGTON — BOARD OF PUBLIC WORKS
WATER DIVISION

Sketch of Service Here

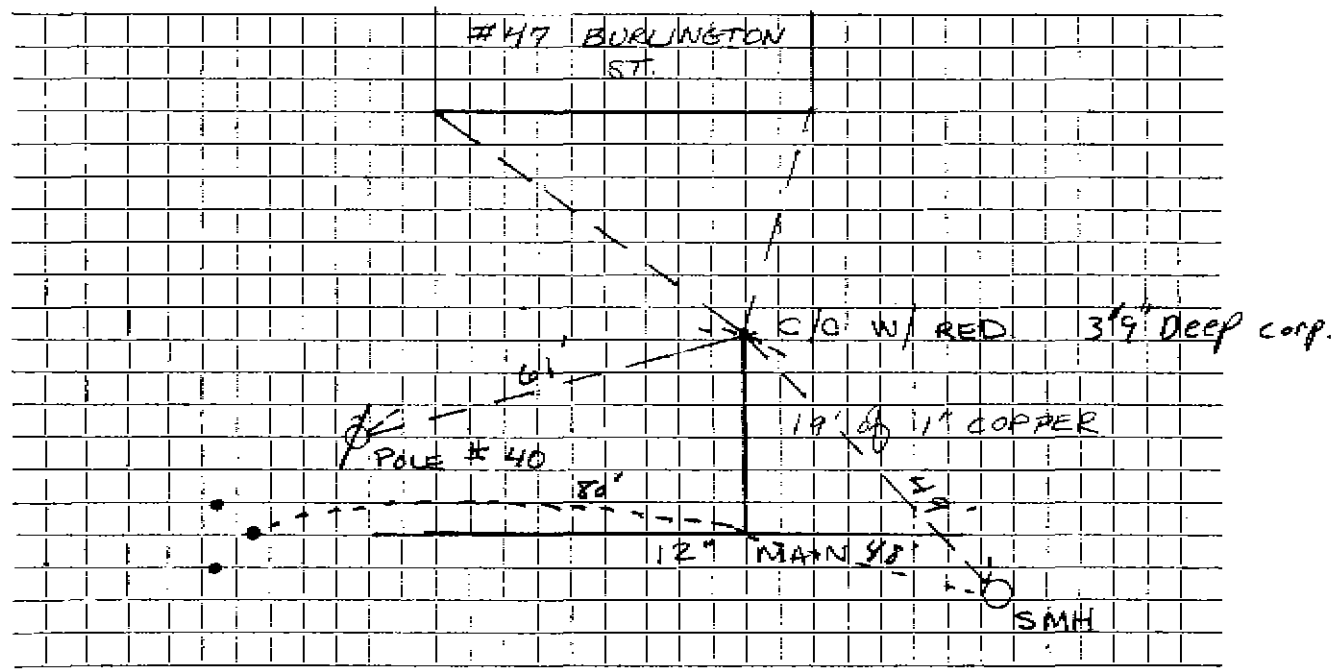

Connection made in BURLINGTON Street. Work completed BY: C.J.P.

Remarks: PART OF CONTRACT # 91-10 "WATER MAIN REPLACE"