

WATER SERVICE RECORD

Name

Service No.

Address 50 BURLINGTON ST.

Location


Repair—Renewal—New Service WATER MAIN REPLACEMENT

Date	Material	Amount	Total	Date	Amount
9-8-39	Labor	6.25			
	10% O.H.	6.3	6.88		
	57' 3/4" Copper @ 15¢		8.55	9/92	OUTSIDE: 19 LF of 1" COPPER
	2 3/4" C. 3 part unions		1.74		C/C w/ BOX
	1 3/4" X 1/2" S & W		2.10		1" CORP.
	1 hr Trucking		.75		3/4" X 1" REDUCER
	Trench repairs		10.44		
			30.70		

DATE 9/92

TOWN OF LEXINGTON — BOARD OF PUBLIC WORKS
WATER DIVISION

Sketch of Service Here

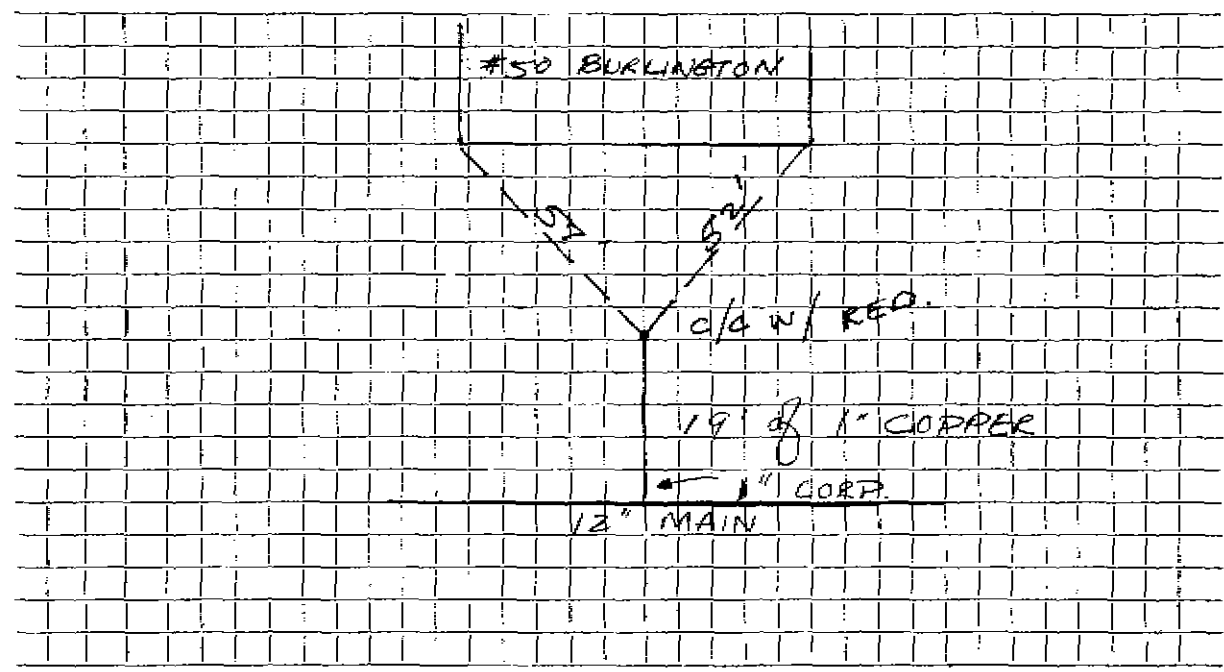

Connection made in ... BURLINGTON Street. Work completed .. BY: C.J.P.

Remarks: ... PART OF CONTRACT # 91-10 ... "WATER MAIN REPLACE"