

Name

Service No. 427

Address 51 Burlington St.

Location 51 Burlington St.

Kind of Pipe

Size

Size of Main

Repair—Renewal—New Service

Location

Date

Material

Amount

Total

Date

Amount

NO-NO 51

Labor

TOWN OF LEXINGTON—BOARD OF PUBLIC WORKS

WATER DIVISION

The undersigned applies for a supply of water at No. _____ St. and hereby agrees to comply with the rules and regulations as now, or at any future time, established by the Board of Selectmen.

Am't. of Estimate \$ _____


Owner P. J. Kinneen

Am't. Paid \$ _____

Address 51 Burlington St.

Builder _____

Sketch of Service Here

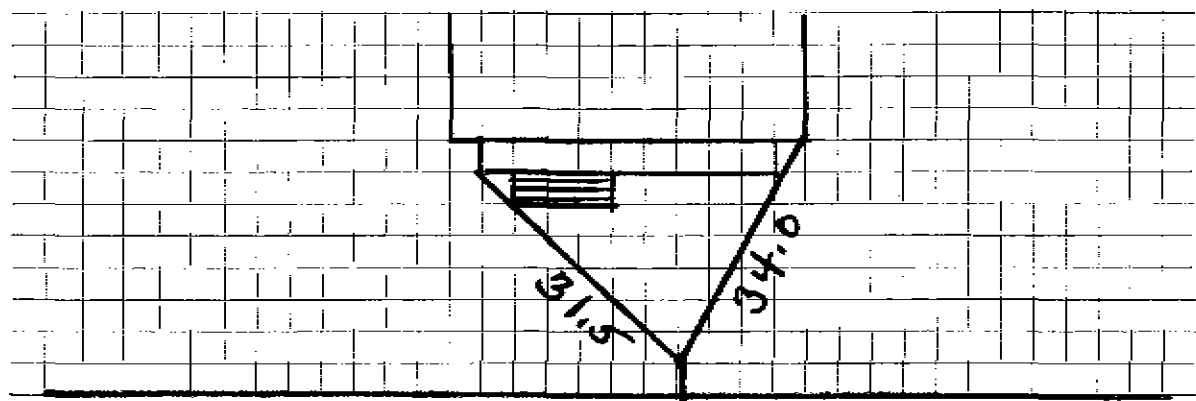

Connection made in Burlington Street. Work completed _____ 19

Remarks:

Tree