


DATE _____

TOWN OF LEXINGTON — BOARD OF PUBLIC WORKS
WATER DIVISION

Sketch of Service Here

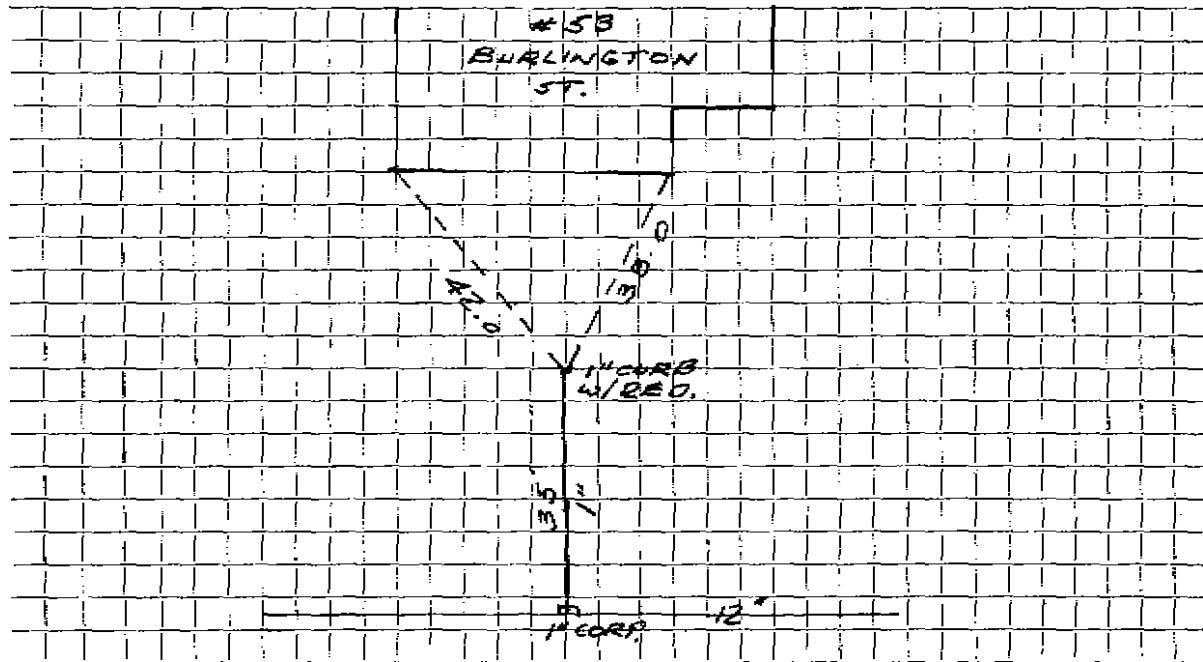

Connection made in BURLINGTON Street. Work completed

Remarks: 3/4" INSIDE

Name Lexington Ridge, Inc.

Service No. # 428 ^{# 4289}

Address 53 Burlington St., Lexington Mass.

Location 53 Burlington St.,

Kind of Pipe

Size

Size of Main

Repair—Renewal—New Service

Location

| Date | Material | Amount | Total | Date | Amount |
|---------------------|------------------------------|-----------|-------------|------------------|--------------|
| Oct. 22, 1940 | 2 hrs. @ 60¢ | 1 20 | | October 24, 1940 | 25 00 |
| <i>Jan 12-31-40</i> | 10% Overhead | <u>12</u> | 1 32 | Dec 31, 1940 | 8 04 |
| | 56' 3/4" Copper tubing @ 19¢ | | 10 64 | | <u>16 96</u> |
| | 1 3/4" C.S. & W. | | 2 25 | | |
| | 1 hr. trucking @ 75¢ | | 75 | | |
| | Trench Repairs | | <u>2 00</u> | | |
| | | | 16 96 | | |
| | Labor | | | | |

Hadley Press, Inc., Lexington

DATE Sept 9, 1940

TOWN OF LEXINGTON—BOARD OF PUBLIC WORKS

WATER DIVISION

The undersigned applies for a supply of water at No. 53 Burlington St. and hereby agrees to comply with the rules and regulations as now, or at any future time, established by the Board of Selectmen.

Am't. of Estimate \$

Owner Lexington Ridge Inc.


Am't. Paid \$

Address 51 Burlington St

Builder Lexington Ridge Inc.

Lexington Mass.

Sketch of Service Here

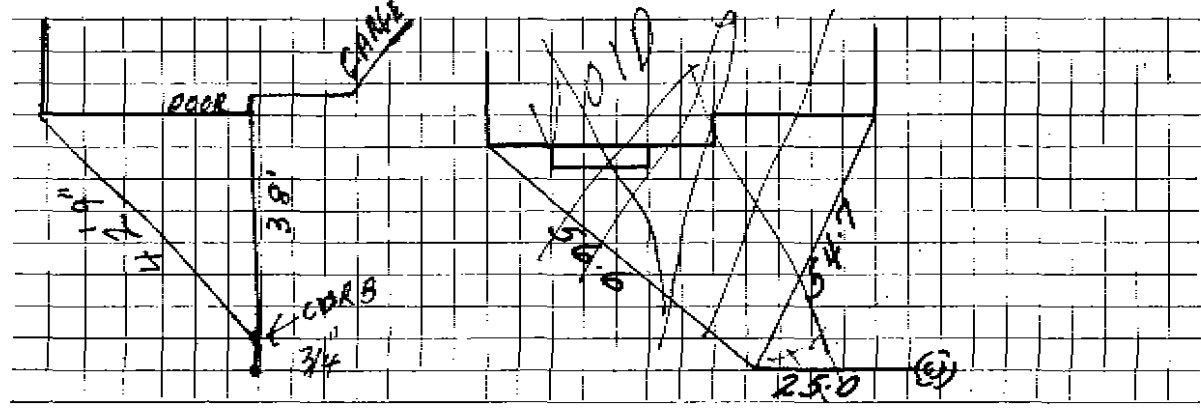

Connection made in _____ Street.

Work completed _____ 19

Remarks: