

WATER SERVICE RECORD

Name

Service No.

Address # 54 BURLINGTON ST.

Location


Repair—Renewal—New Service

Date	Material	Amount	Total	Date	Amount
11-14-47	Labor	1.05			
	10% OH	.11	1.16		
39'	3/4" Copper @ 27		10.53		
1	3/4" C x 1/2" I w/ 54W		3.15	9/ 92	<u>OUTSIDE :</u>
1	hr Trucking		.75		C/C w/ BOX
	10 x 3 Patch		10.00		1" CORP
			<u>25.59</u>		3/4" x 1" REDUCER

DATE 9/92

TOWN OF LEXINGTON — BOARD OF PUBLIC WORKS
WATER DIVISION

Sketch of Service Here

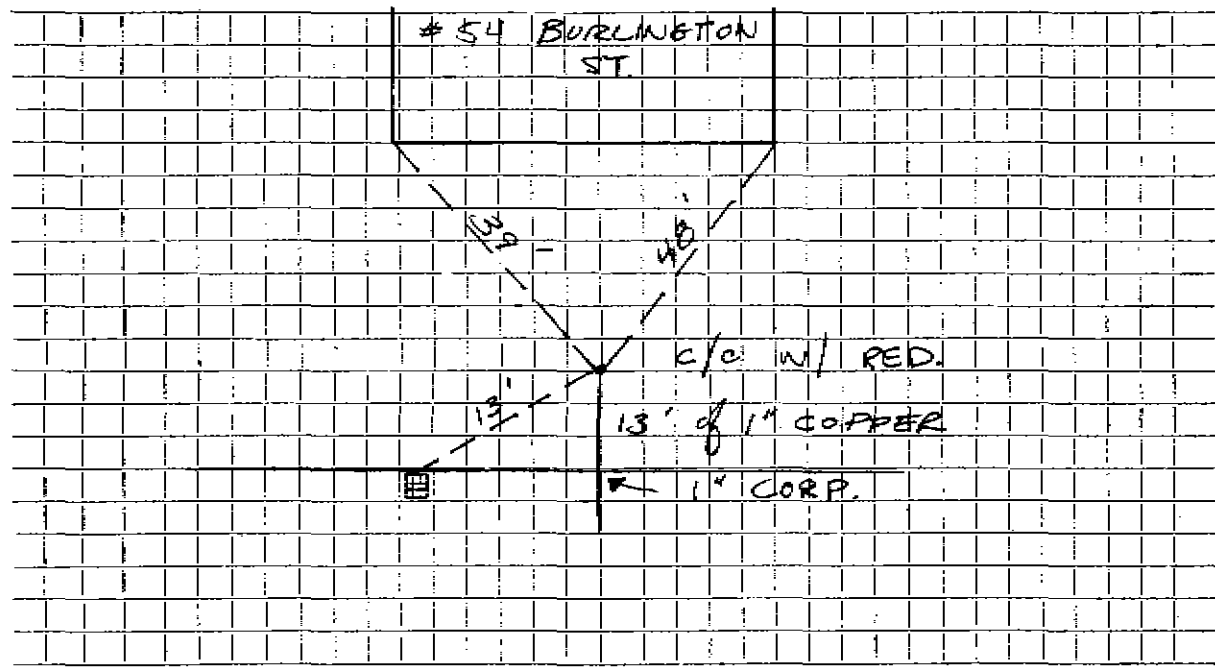

Connection made in ..BURLINGTON..... Street. Work completed ..BY GJP.....

Remarks: ..PART OF CONTRACT # 91-10 "WATER MAIN REPLACE".....