

WATER SERVICE RECORD

Name

Service No.

Address 60 BURLINGTON ST.

Location


Repair—Renewal New Service C. J. P. & Sons # 91-10

Date	Description	Amount	Total	Date	Amount
9-16-92	<p><u>OUTSIDE</u> 13 LF 1" COPPER 1" COPP. 1" CURB W/RED.</p>				
8/25/61	LABOR	2.04			
	10% O.H.	.20	2.24		
34'	3/4" Copper Tubing	.42	14.28		
1	3/4" C x 1/2 IWH Stop + Waste		6.17		
			<u>22.69</u>		

DATE _____

TOWN OF LEXINGTON — BOARD OF PUBLIC WORKS
WATER DIVISION

Sketch of Service Here

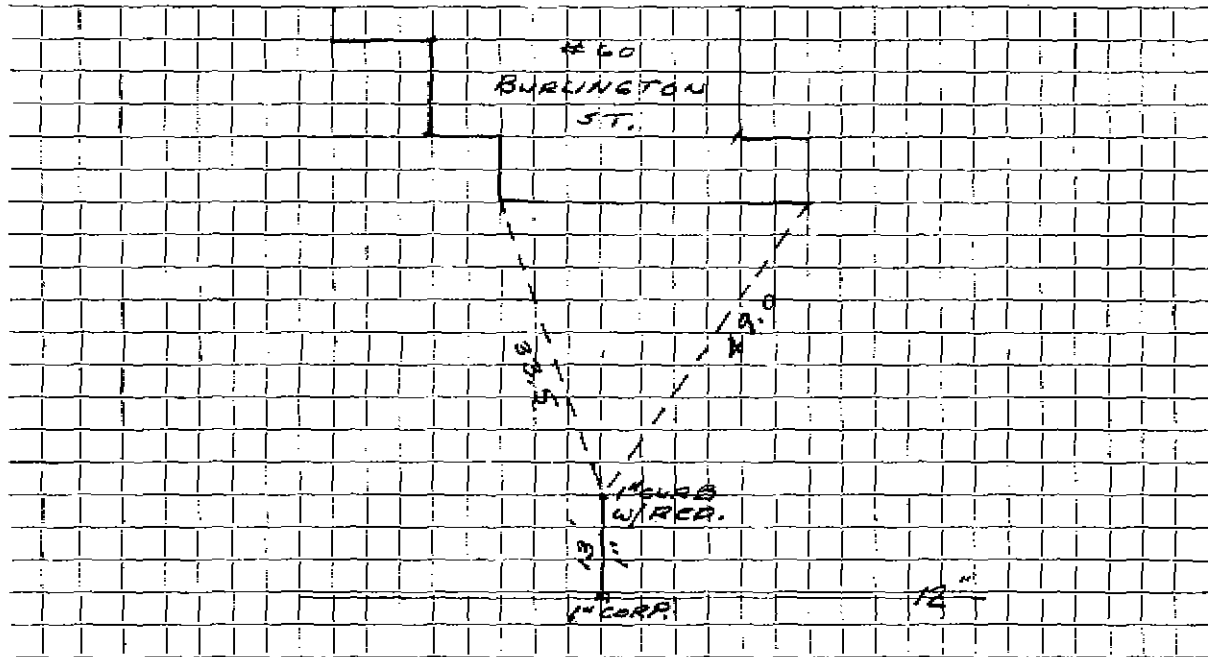

Connection made in BURLINGTON Street. Work completed

Remarks: 3/4" INSIDE