

WATER SERVICE RECORD

Name

Service No.

Address 61 BURLINGTON ST.

Location

Repair—Renewal—New Service CJP 95ms # 91-19


Date		OUTSIDE	Amount	Total	Date	INSIDE	Amount
9-15-92		25 LF 1" COPPER			3/30/60	LABOR	27.91
		1" CORP.			3/31/60	"	15.03
		1" CURB W/RED.					42.94
						10 90 o.t.	4.29
					33'	$\frac{3}{4}$ " copper Tubing AT	42
					1	$\frac{3}{4}$ " C X $\frac{1}{2}$ " I WH STOP + WASTE	
					2	hrs. Trucking	1.75

DATE \_\_\_\_\_

TOWN OF LEXINGTON — BOARD OF PUBLIC WORKS

WATER DIVISION

Sketch of Service Here

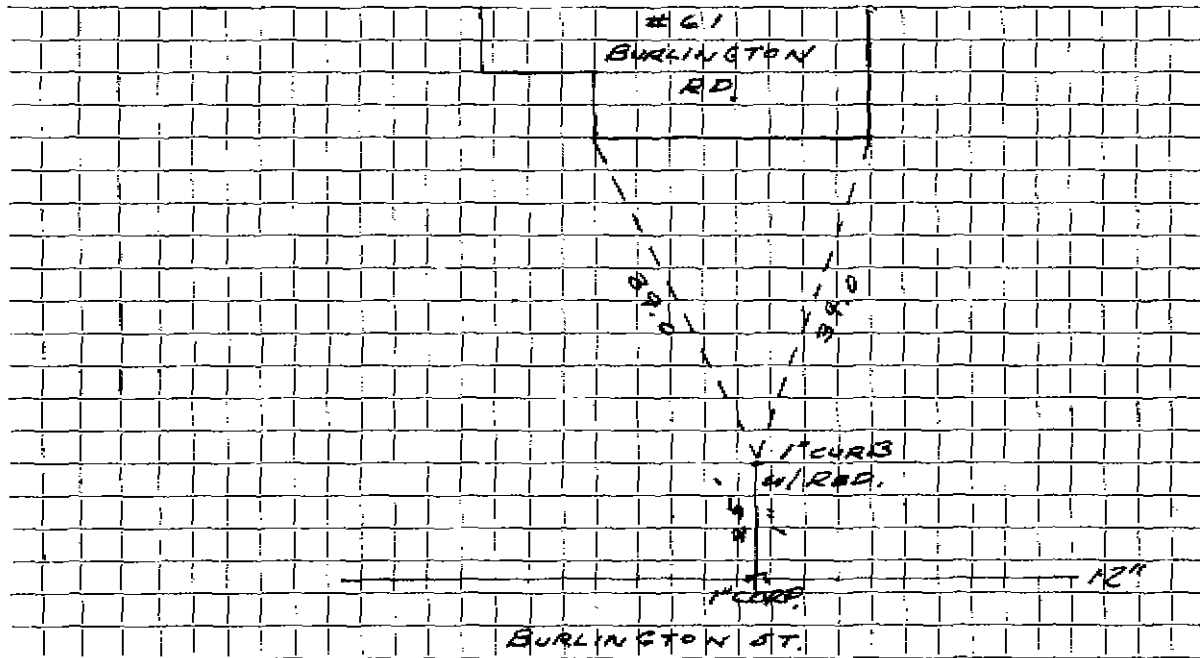

Connection made in BURLINGTON Street. Work completed .....

Remarks: 3/4" INSIDE .....