

WATER SERVICE RECORD

Name *Kinneen Park*

Service No.

Address *67 Burlington Street*

Location

Repair—Renewal—New Service


Date	Material	Amount	Total	Date	Material	Amount
<i>7/9/86</i>	<i>18' 1" Copper tubing</i>					
	<i>1 1" Corp</i>					
	<i>1 1" Curb</i>					
	<i>Watering</i>					
					<i>Drinking Fountain</i>	
					<i>OUTSIDE</i>	
				<i>7/9/86</i>	<i>18' 3/4" Copper</i>	
					<i>1 3/4" Corp.</i>	
					<i>1 3/4" Curb</i>	

DATE \_\_\_\_\_

TOWN OF LEXINGTON — BOARD OF PUBLIC WORKS

WATER DIVISION

Sketch of Service Here

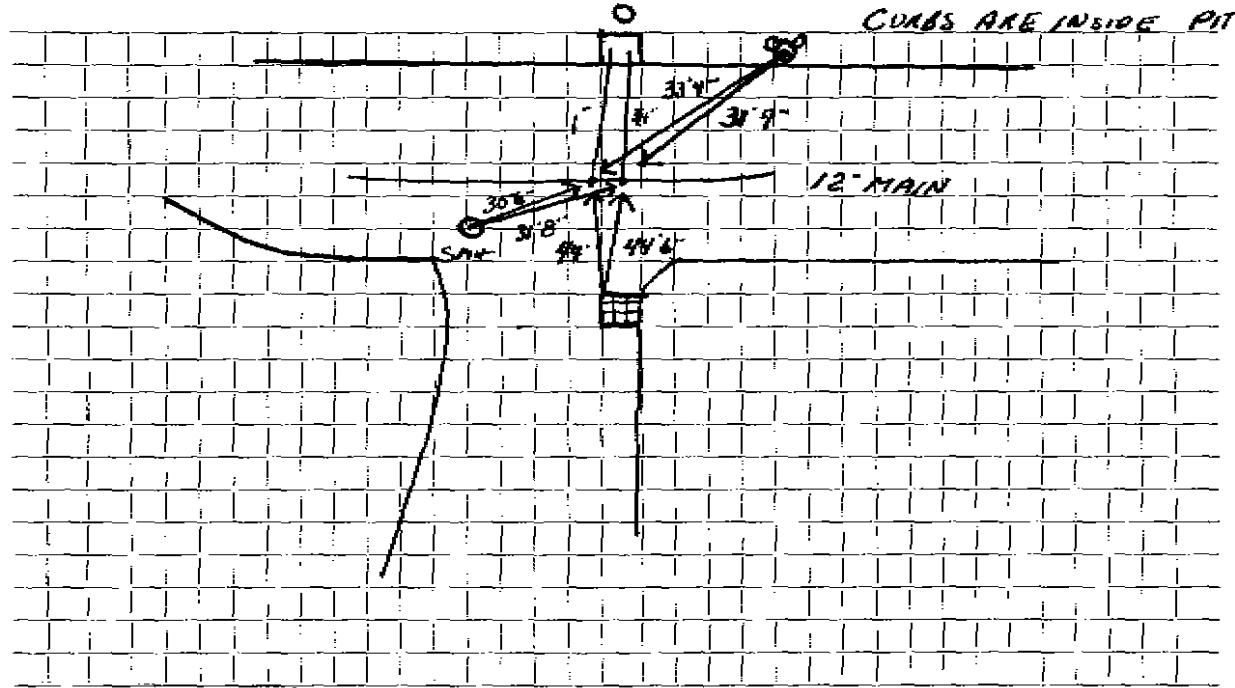

Connection made in ..... Street. Work completed .....

Remarks: .....  
.....  
.....