


DATE _____

TOWN OF LEXINGTON — BOARD OF PUBLIC WORKS
WATER DIVISION

Sketch of Service Here

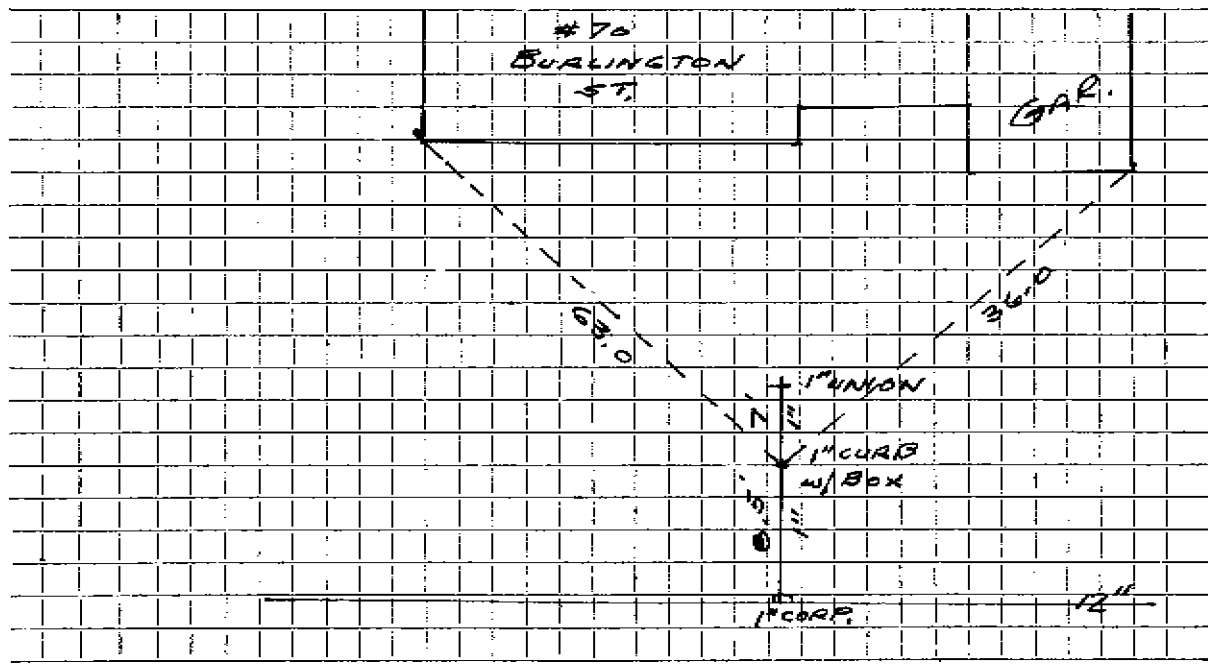

Connection made in BURLINGTON Street. Work completed

Remarks: 1\" INSIDE