WATER SERVICE RECORD

Name

Service No.


Addr	ess	74 BURLINGTON	. .						
Locat									
Repa	ir—R	enewal New Service C.	18+50n5	#91-10					
Date		OUTSIDE	Amount	Total	Date	 -	Inside	Amount	=
				#	i	,, <u> </u>	27/3/4 2		=
9-18-	92		··	 	10/36/9	104	· · · · · · · · · · · · · · · · · · ·		
	\ \	I'CURB W/RED.		 	14/1	14	Copper lubing		
	\ 	I'CORP.		·}		3	Copper Tubing C.S. +W		
	 				. ij)			
	· ·					,			
	{			1	_ 	\ \			_
	\\ 1			 	 	 			
	<u> </u>	 		₩	- 	 			_
	, 	' ! 		 	 	 			
	: ;	·		·#		\ 			_
	, 	·	·	<u> </u>	- 	\ 	 		
	<u> </u>	<u>'</u>	· 	<u> </u>		\ 			
	i		1	ii	<u>-</u>	!	 	ļ	
	<u> </u>)	<u></u>	III	!			_
	 	 		#	- 				_
	1	<u></u>		 		`	<u> </u>	- 	_
	 	i				<u> </u>			_
	ļ ' ; - 	 		 		, 		·	
	; ' ;	 	<u>_</u> i	' 	 	<u> </u>	· · · · · · · · · · · · · · · · · · ·	! 	
	, '	l L	ĺ	1	ţt II	İ	· 	, 	

~		

TOWN OF LEXINGTON - BOARD OF PUBLIC WORKS

WATER DIVISION

Sketch of Service Here

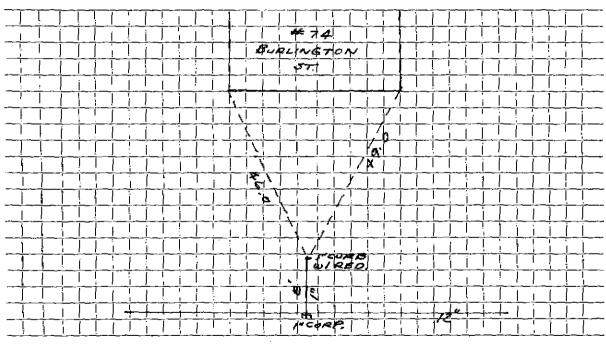

Connection made in SugureTow	Work completed
Remarks: 74 INSIDE	 ,,,,,,,,,,,,,,,,,,,,,,,,,,,,,,,,,,,,,,,