


DATE 7-3-86

TOWN OF LEXINGTON — BOARD OF PUBLIC WORKS
WATER DIVISION

Sketch of Service Here

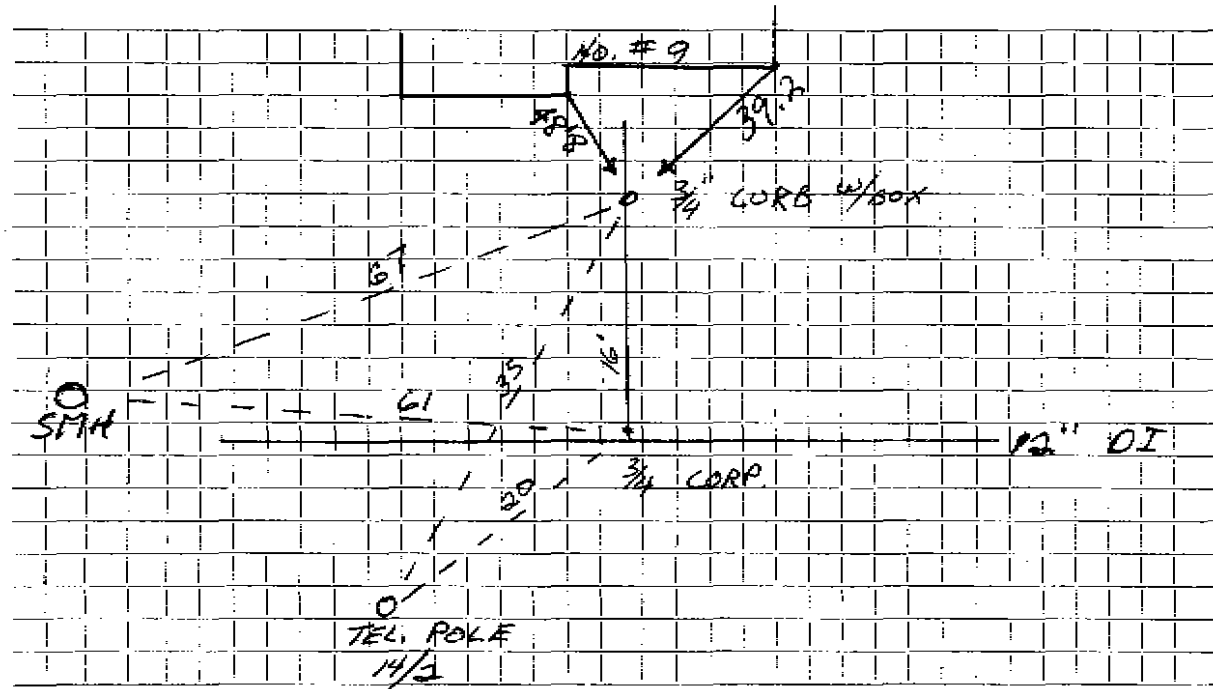


Connection made in ~~HAY~~ BURL Street. Work completed 7-3-86
Remarks: NEW 12" OI MAIN, NEW 3/4" SERVICE

DATE _____

TOWN OF LEXINGTON — BOARD OF PUBLIC WORKS

WATER DIVISION

Sketch of Service Here

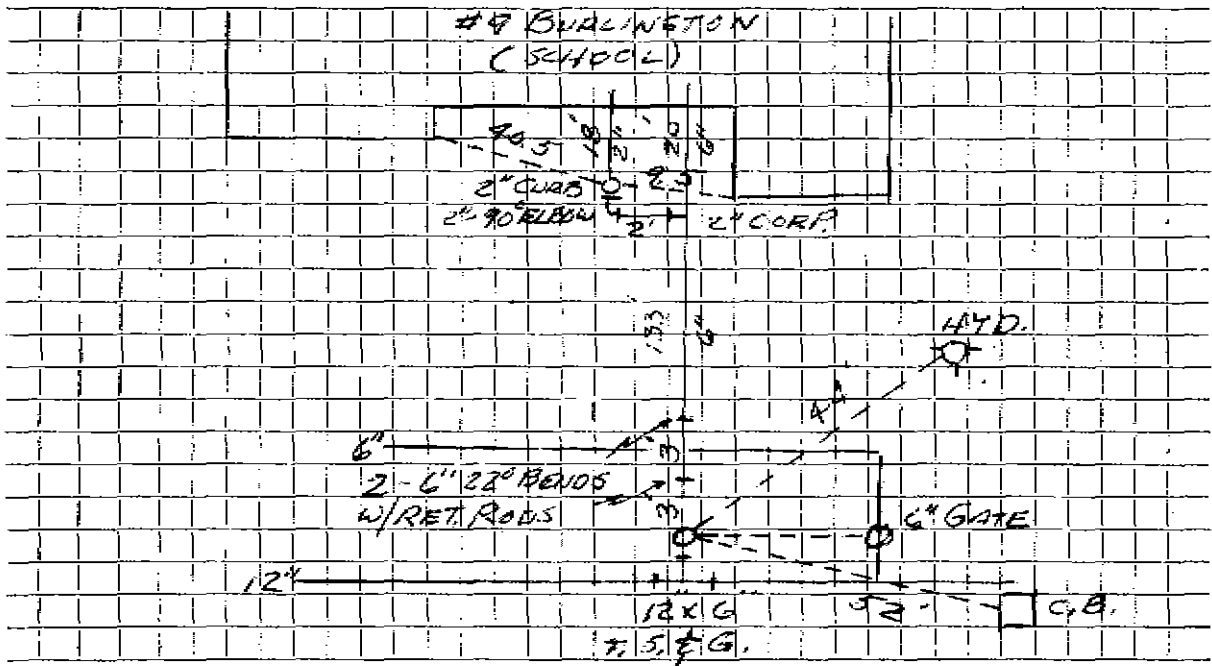

Connection made in BURLINGTON Street. Work completed

Remarks: NEW SERVICE TO SCHOOL