

Name H. N. Crocker (Roger A. Pietro)

Service No. 43 3132

Address 93 Burlington Street

Location ~~220 Grove Street~~ 93 Burlington St.

Kind of Pipe

Size

Size of Main

~~Repair~~ ~~Renewal~~ New Service

Com. 9-23-46

Location

Date	Material	Amount	Total	Date	Amount
June 11, '46	Labor	90	90	June 5, '46	30 00
	10% Overhead		09	Oct 25, '46	2 36
	43'-3" Copper Tubing @.1315		7 80		32 36
	1-1/2" C x 1/2" I. .H. Stop & Waste		3 82	June 11, '46	27 90
	Patching 29 x 3		20 00	37'-3" Copper Tubing @.1315	4 90
	Trucking 1 hr.		75	1-3/4" C. Curb-cock	1 70
			32 36	1-1/2" C x 1/2" C. Curb-cock	3 30
				1-Box & Rod	1 65
				1-1/2" Offset Tail Piece	90
				1-1/2" Straight Tail Piece	90
				Compressor 1 hr. @1.75	1 75
				Trucking 1 hr. @.75	75
					44 75
	<u>Trench Dug By Owner</u>				
	Labor				

*Reported
Paid
Non-Charge*

Lindley Press, Inc., Lexington

DATE _____

TOWN OF LEXINGTON—BOARD OF PUBLIC WORKS

WATER DIVISION

The undersigned applies for a supply of water at No. _____ St. and hereby agrees to comply with the rules and regulations as now, or at any future time, established by the Board of Selectmen.


Am't. of Estimate \$ _____

Owner _____

Am't. Paid \$ _____

Address _____

Builder _____

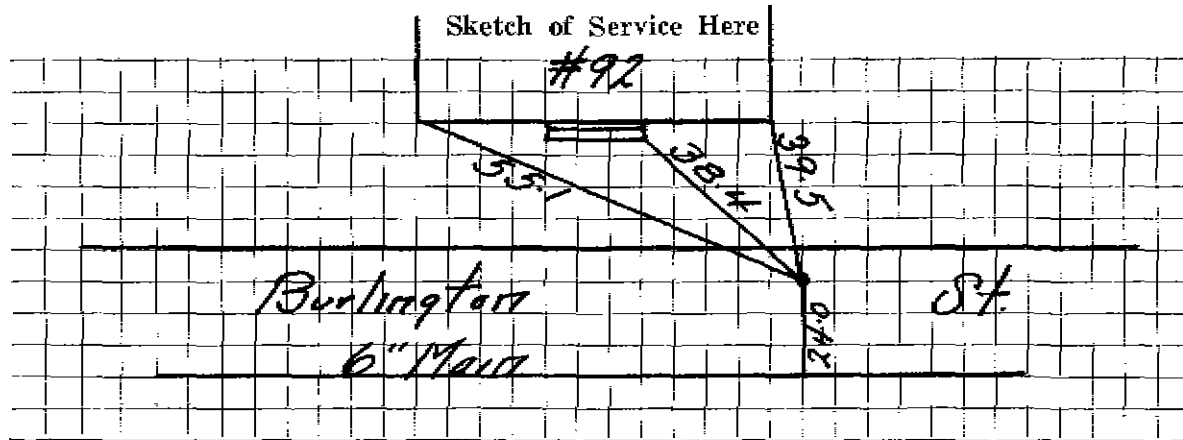

Connection made in _____ Street. Work completed _____ 19

Remarks: