

256

WATER SERVICE RECORD

Name Benjamin Franklin Homes

Service No. 71

Address 96 Burlington Street

Location

~~REPAIR REQUEST~~ - New Service

Comm 7-12-61


Date	Material	Amount	Total	Date		Amount
6-7-61	Labor	4.30		5-31-61	Deposit	50.00
	10% O.H.	.43	4.73	7-12-61	Retund	89
85'	3/4" Copper Tubing @.42		35.70			49.01
1	3/4" c x 1/2 I.W.H. Stop & Waste	6.17				
1	3/4" C 3 part union	2.41			NON CHARGE	
			49.01	6-7-61	Labor	3.38
				35'	3/4" Copper Tubing @.42	14.70
				1	3/4" C Corp Cook	4.91
				1	3/4" C Curb Cook	6.28
				1	Box & Rod	4.90
				1 1/2	Straight tailpiece	.50
				1 1/2	Offset tailpiece	.50
						35.17

* Applied to 5/11/64

DATE _____

TOWN OF LEXINGTON — BOARD OF PUBLIC WORKS
WATER DIVISION

Sketch of Service Here

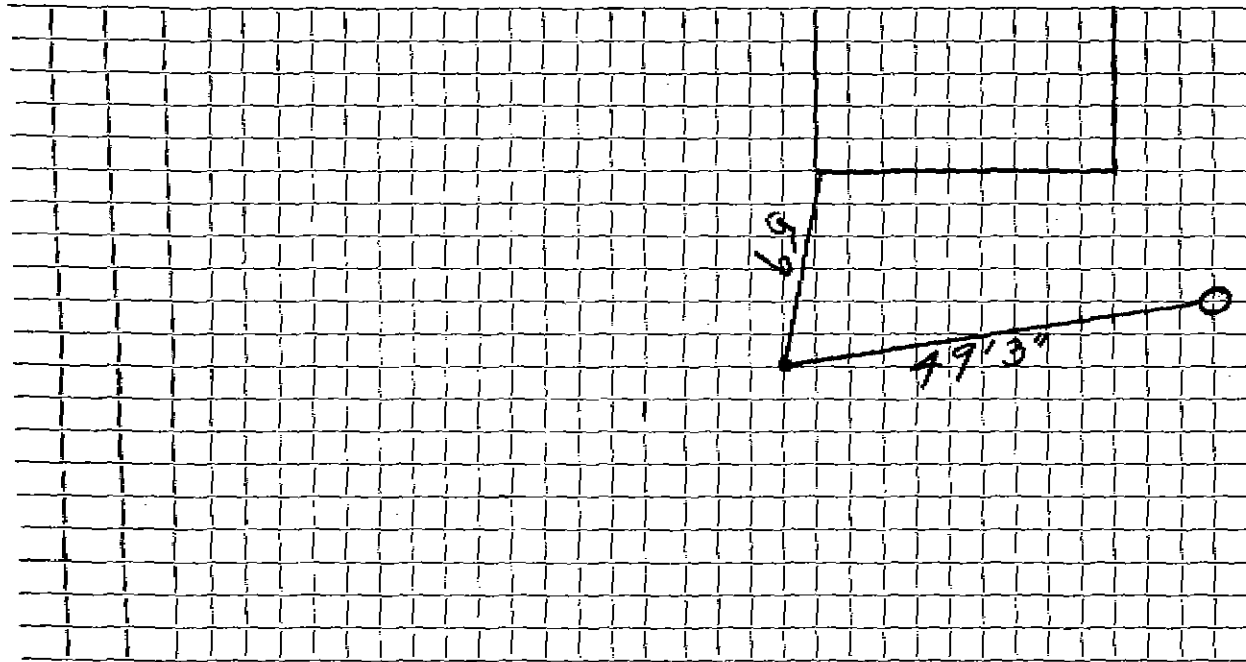

Connection made in Street. Work completed

Remarks:

.....

.....