

WATER SERVICE RECORD

# 313

Name Arthur Williams

Service No. 49

Address 99 Burlington St.

Location Lexington

Repair/Replacement—New Service COM. 4-6-53


Date	Material	Amount	Total	Date	Amount
3/20/53	Labor	6 04		3-9-53	Deposited 25 -
	10% overhead	60	6 64	4-6-53	Refunded (23 35)
	39' - 3/4" Copper Tubing @ .34		13 26		NON CHARGE 51 65
	1-3/4" C x 3/8" I.W.H. stop & waste	4 00		3/20/53	Labor 6 04
	3 Hr. Littlefield Shovel @ 7.00	21 00			11' - 3/4" copper tubing @ .34 3 74
	1 Hr. Trucking	75			1 - 3/4" C. corp-cock 4 33
	Patching 6 x 3	6 00			1 - 3/4" C x 3/4" C. curb-cock 4 67
			51 65		1 box and rod 3 90
					1 - 1/2" straight tail piece 50
					1 - 3/8" offset tail piece 50
					1 hr. Littlefield shovel 7 00
					1 hr. trucking 75
					<u>31 43</u>

DATE \_\_\_\_\_

TOWN OF LEXINGTON — BOARD OF PUBLIC WORKS

WATER DIVISION

Sketch of Service Here

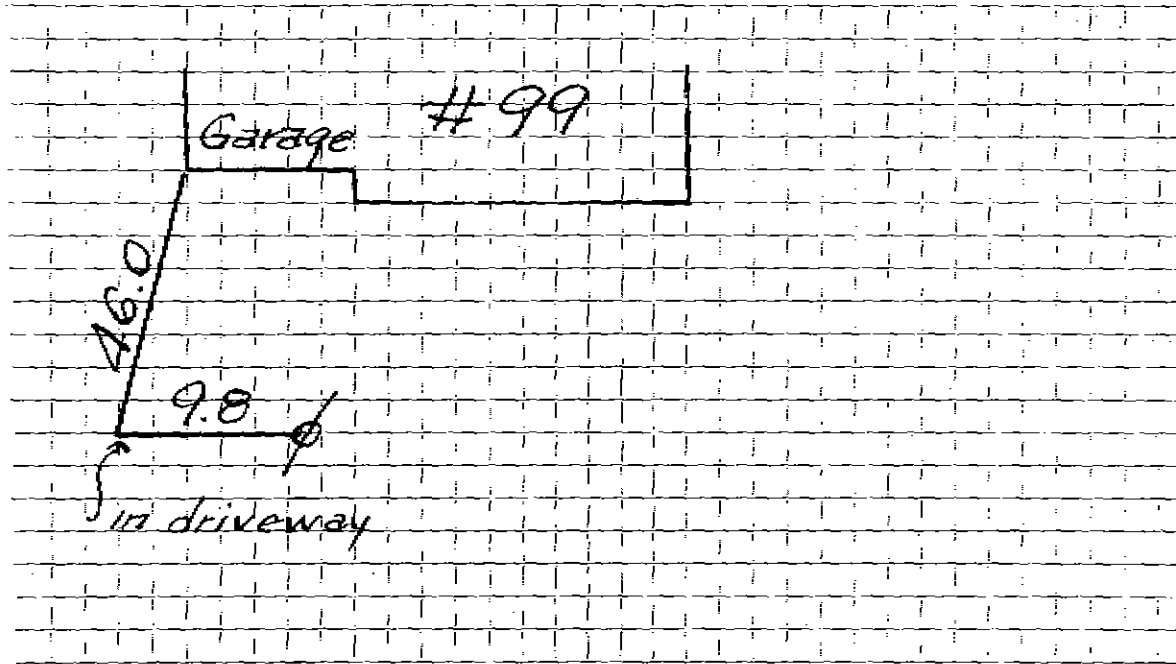

Connection made in ..... Street. Work completed .....

Remarks: .....  
.....  
.....