

WATER SERVICE RECORD

Name White Const. Co., Inc.

Service No. 184

Address Junior High School - Burlington Street

Location

Repair—Renewal—New Service

Comm 3-16-59


Date	Material	Amount		Total		Date	Amount
7/15/58	Labor	52	80			9-3-58	500 00
7/16/58	"	29	49			7-16-59	368 48
		82	29				131 52
	10% overhead	8	23	90	52		
	4 hrs. Town Shovel @ 6.50			26	00		
	1 hr. Trucking			3	00		
	4 hrs. Trucking @ .75			3	00		
	2 hrs. Hough Loader @ 3.00			6	00		
	1 hr. Rodgers Trailer			3	00		
				131	52		

DATE _____

TOWN OF LEXINGTON — BOARD OF PUBLIC WORKS

WATER DIVISION

Sketch of Service Here

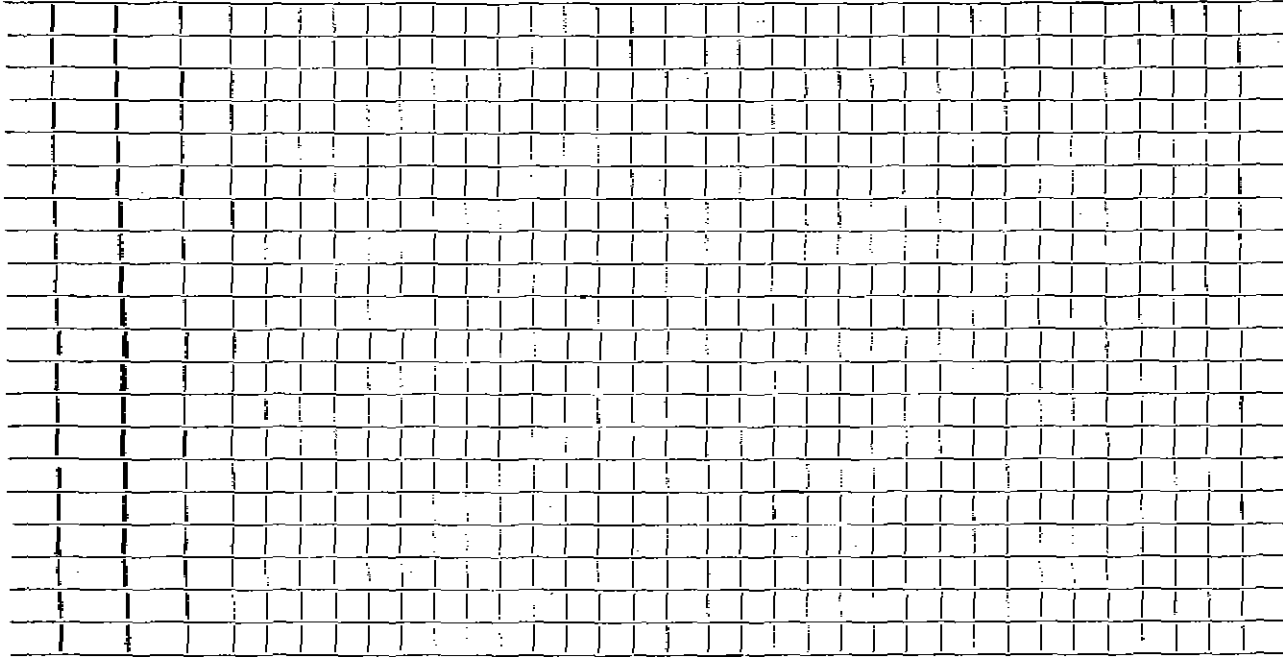

Connection made in Street. Work completed

Remarks:
.....
.....