


DATE _____

TOWN OF LEXINGTON — BOARD OF PUBLIC WORKS
WATER DIVISION

Sketch of Service Here

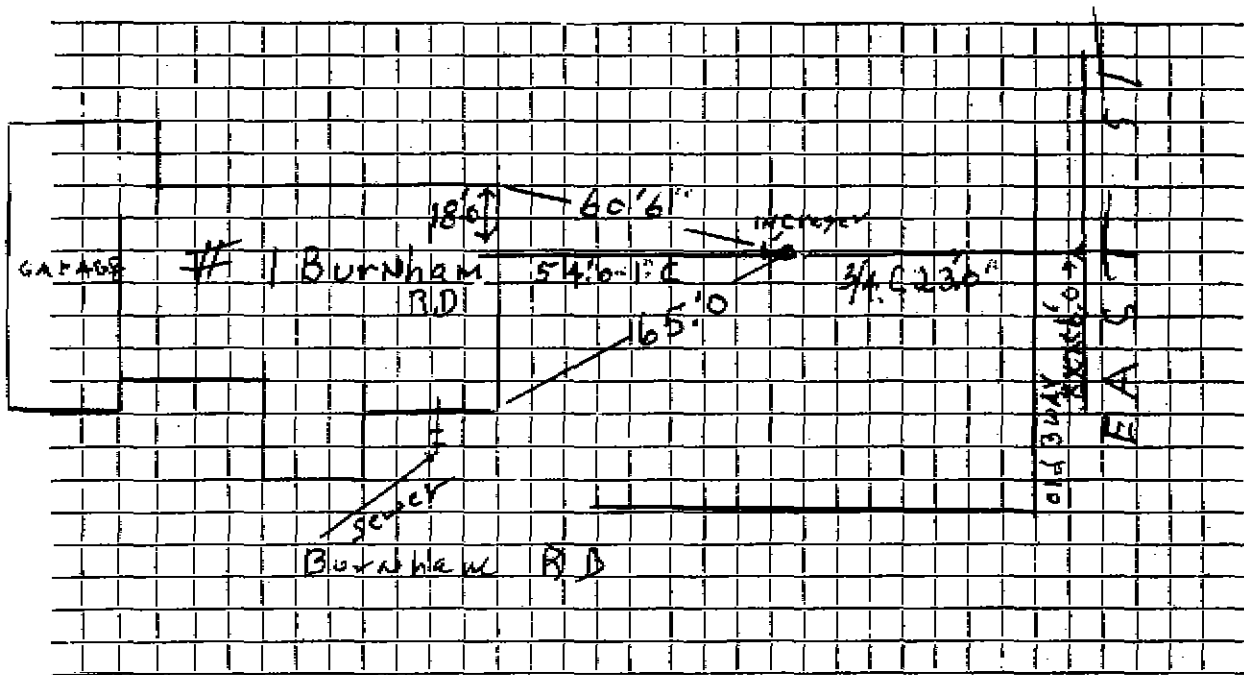

Connection made in East St Street.

Work completed 1/9/06 J. McLaughlin

Remarks: old Burnham Branch killed 1957