

WATER SERVICE RECORD

Name Mark Moore

Service No. 240

Address 4 Burnham Road

Location

Repair ~~General~~ - New Service

Comm. 12-9-57


Date	Material	Amount	Total	Date	Amount
10/22/57	labor	2 15		10-21-57	Deposit 50 00
	10% overhead	22		12-2-57	Refund 19 42
			2 37		\$ 30 58
	60' 3/4" copper tubing @ .375	22 50			NON CHARGE
	1 3/4" Cx 1/2 IWH stop & waste	4 96			labor 2 15
	1 hr. trucking @ .75	75			25' 3/4" copper tubing @ .375 9 38
			30 58		1 3/4" C corp cock 4 64
					1 3/4" C curb cock 5 94
					1 box & rod 4 62
					1 1/2 straight tail pc. 50
					1 1/2 offset tail pc. 50
					27 73

DATE 3/8/59

TOWN OF LEXINGTON — BOARD OF PUBLIC WORKS

WATER DIVISION

Sketch of Service Here

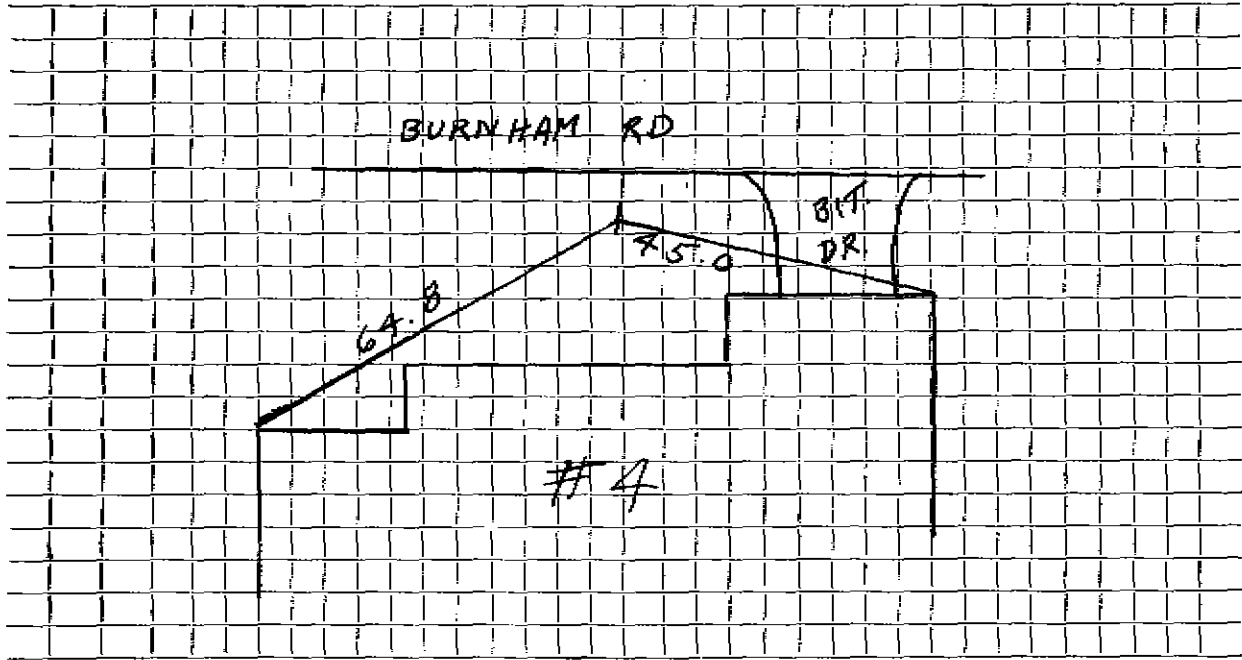

Connection made in BURNHAM RD Street. Work completed

Remarks:
.....
.....