

WATER SERVICE RECORD

#5320

Name Moore Realty Trust

Service No. 79

Address 5 Burnham Road

#9567

Location

~~Repair~~ ~~Renewal~~ New Service

Comm 6-22-59


Date	Material	Amount	Total	Date		Amount
5-5-59	Labor	1.77		4-29-59	Deposit	50.00
	10% O.H.	.18	1.95	6-22-59	Refund	19.46
60	3/4" Copper tubing @.3666		22.00			30.54
1	3/4" C x 1/2 I.W.H. Stop & Waste		5.84		NON CHARGE	
L	hr. Trucking @.75		.75	10-22-57	Labor	1.76
			30.54		6' 3/4" Copper tubing	2.25
					3/4" C Corp Cock	4.64
					1 3/4" C Curb Cock	5.94
					1 Box & Rod	4.62
					1 hr. Trucking @.75	.75
						19.96
					1 1/2 Straight Tailpiece	.50
					1 1/2 Offset tailpiece	.50
						20.96

DATE 3/8/59

TOWN OF LEXINGTON — BOARD OF PUBLIC WORKS

WATER DIVISION

Sketch of Service Here

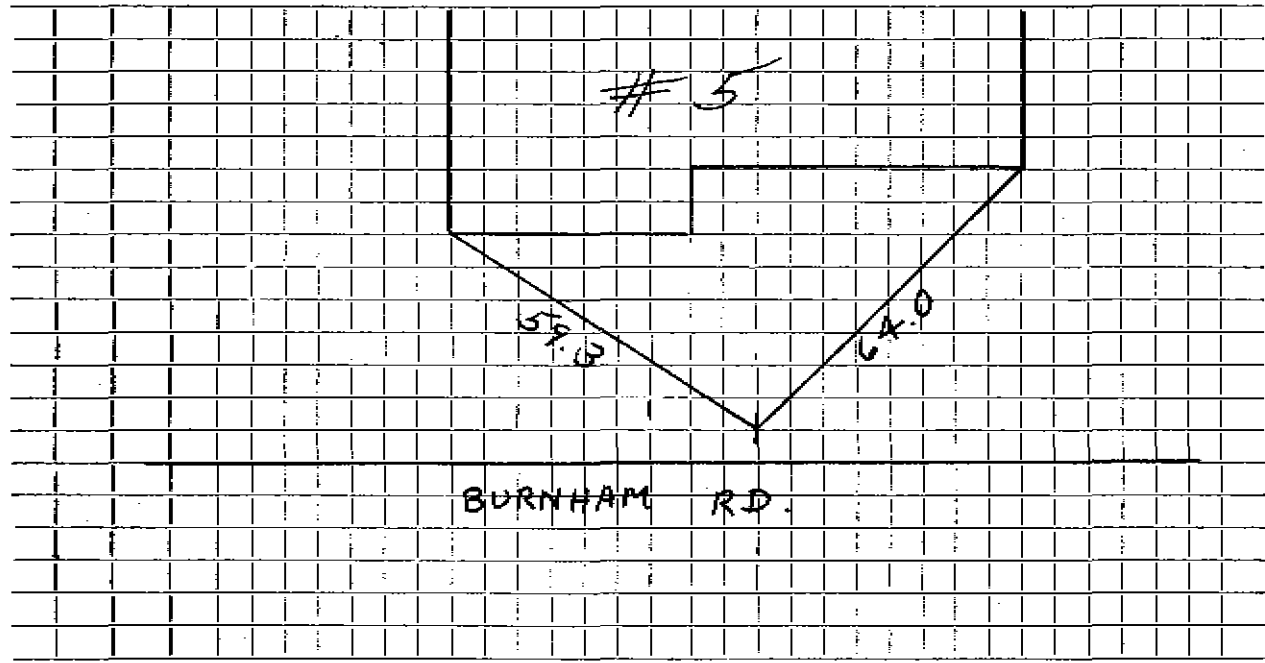

Connection made in .. BURNHAM RD. Street. Work completed

Remarks:
.....
.....