

WATER SERVICE RECORD

Name

Service No.

Address 7 Burnham Rd

Location Permit # 1407

Repair—Renewal—New Service


| Date | Material | Amount | Total | Date | OUTSIDE | Amount |
|--------|-----------|--------|-------|------|--|--------|
| 6/2/00 | Inside | | | 6/00 | | |
| 58' | 1" COPPER | | | | 9'6" of 1" Copper 1-1" Mueller Corp 1 Buffalo Box 1" Curb | |

DATE 6-12-00

TOWN OF LEXINGTON — BOARD OF PUBLIC WORKS

WATER DIVISION

Sketch of Service Here

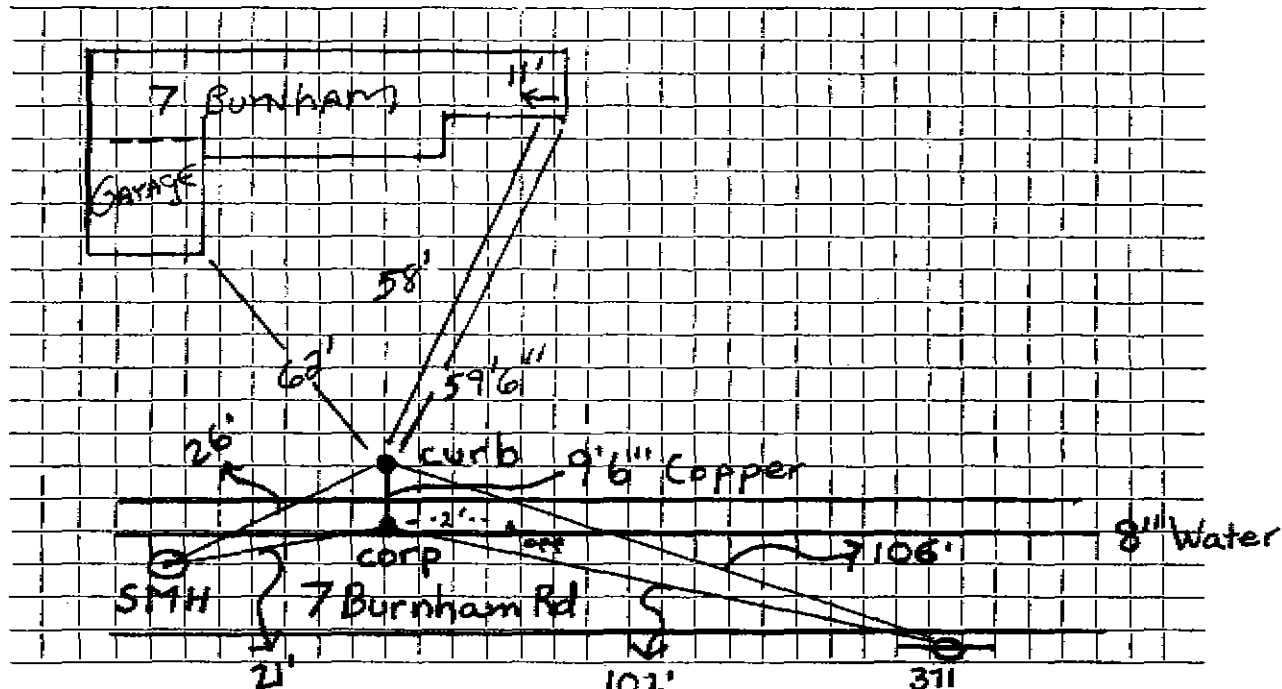

Connection made in Street. Work completed $\frac{311}{5}$

Remarks: *Not to Scale, Service is straight out of House to Main