

Name Carsan Homes Incorporated

Service No. 106

Address 1 Burns Road

Lexington, Mass.

Location 1 Burns Road #3175

Kind of Pipe

Size

Size of Main

~~Repair - Renewal~~ New Service

Com. 9-5-50

Location

Date	Material	Amount	Total	Date	Amount
May 20, '50	Labor	1 50	1 50	May 20, '50	10 00
	10% Overhead		15		2 51
	1 - 3/4" C x 1/2" I.W.H. S&W		3 29		5 69
	Trucking 1 hr. @ .75		75		
			5 69		
				May 20, '50	7 84
				6' - 3/4" Copper Tubing @.23	1 38
				1 - 3/4" C Corp-cock	3 15
				1 - 3/4" C x 3/4" C Curb-cock	3 85
				1 - Box & Rod	3 60
				1 - 1/2" Offset Tail Piece	38
				1 - 1/2" Straight Tail Piece	38
				Town Shovel 1 hr. @ 3.00	3 00
				Allis Chalmers 1 hr. @ 3.00	3 00
				Trucking 1 hr. @ .75	75
					27 33

*Mayer's* Deposited

No Charge

TOWN OF LEXINGTON - BOARD OF PUBLIC WORKS

**WATER DIVISION**

The undersigned applies for a supply of water at No..... St. and hereby agrees to comply with the rules and regulations as now, or at any future time, established by the Board of Selectmen.

Am't of Estimate \$.....


Owner .....

Am't Paid \$.....

Address .....

Builder .....

Sketch of Service Here

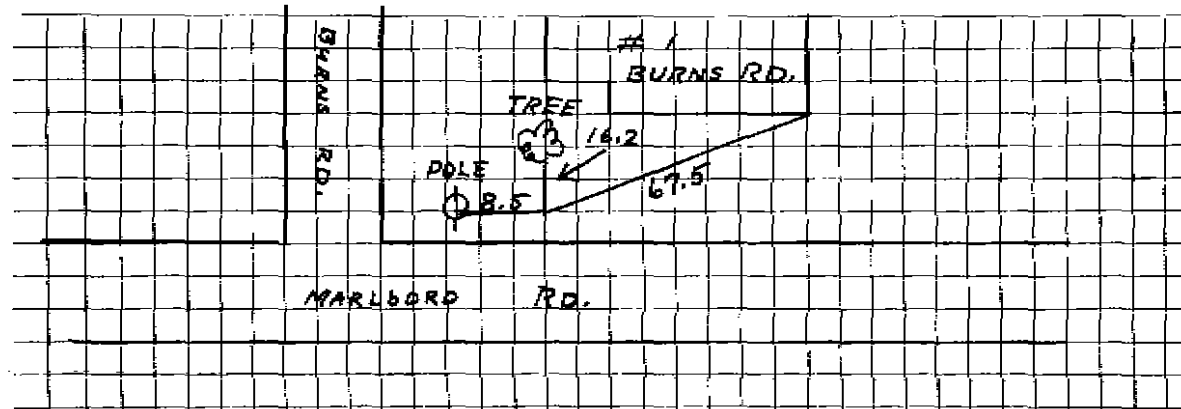

Connection made in ..... Street.

Work completed .....19

Remarks: