

Name Carsan Homes, Inc.

Service No. 106

Address 2 Burns Road

#5376

Lexington, Mass.

Locatic 2 Burns Road

Kind of Pipe

Size

Size of Main

Repair - Renewal - New Service

Com. 9-5-50

Location

Date

Material

Amount

Total

Date

Amount

June 26, '50	Labor	1 30	1 30
	10% Overhead		13
	1 - 3/4" C x 1/2" I.W.H. S&W		3 29
	Trucking 1 hr. @ .75		75
			<u>5 47</u>

May 28 '50 *Deposited* 10.00

No Charge 5.47

Service Relocated by James Redmond

1 3/4" Union

June 26, '50	Labor	3 75
	10' - 3/4" Copper Tubing @.23	2 30
	1 - 3/4" C Curb-cock	3 15
	1 - 3/4" C x 3/4" C Curb-cock	3 85
	1 - Box & Rod	3 35
	1 - 1/2" Straight Tail Piece	38
	1 - 1/2" Offset Tail Piece	38
	Trucking 1 hr. @.75	75
	Littlefield Shovel 1 hr. @ 7.00	7 00
		<u>24 91</u>

Labor

Hadley Press, Inc., Lexington 4/22/81

TOWN OF LEXINGTON — BOARD OF PUBLIC WORKS

WATER DIVISION

The undersigned applies for a supply of water at No. _____ St. and hereby agrees to comply with the rules and regulations as now, or at any future time, established by the Board of Selectmen.

Am't. of Estimate \$ _____


Owner _____

Am't. Paid \$ _____

Address _____

Builder _____

Sketch of Service Here

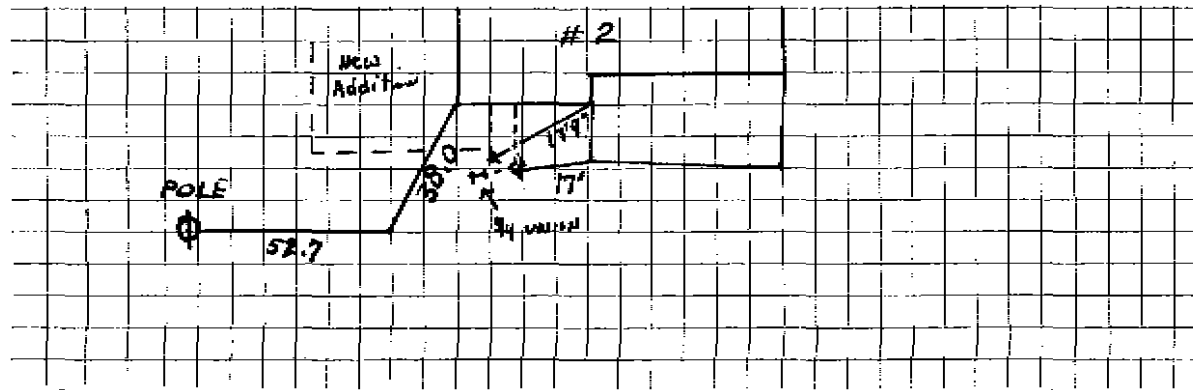

Connection made in _____ Street. Work completed _____ 19__

Remarks: