


DATE 9-25-2001

TOWN OF LEXINGTON — BOARD OF PUBLIC WORKS

WATER DIVISION

Sketch of Service Here

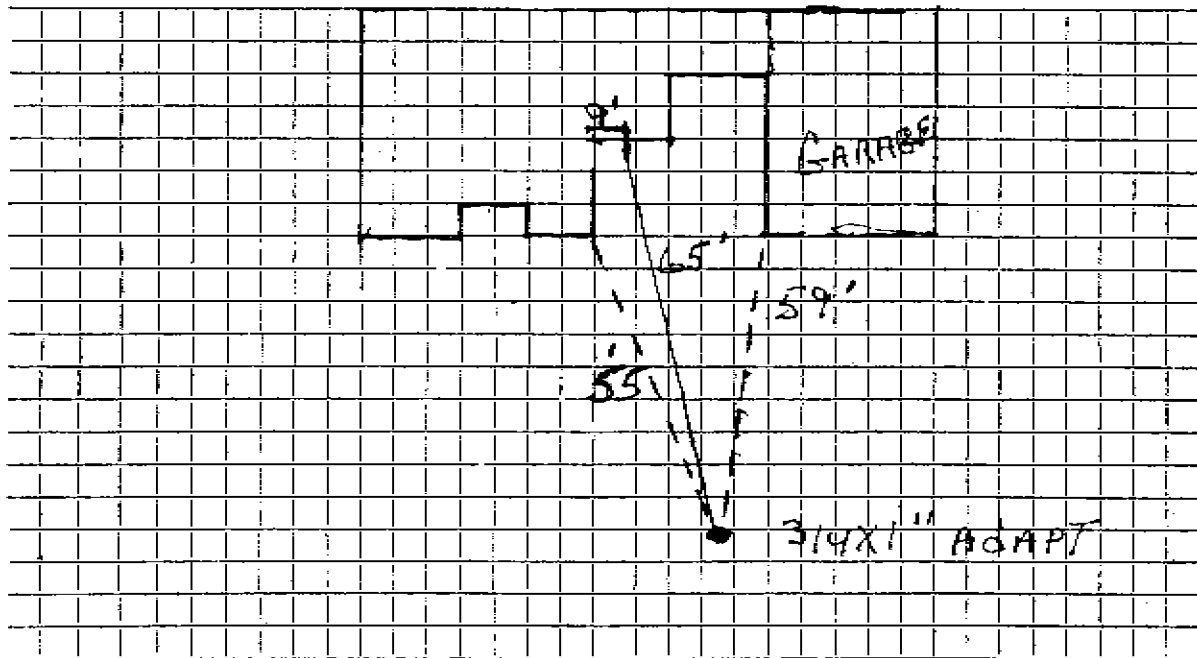

Connection made in B. URRONGHS..... Street. Work completed

Remarks: INSTALLED BY J. McLAUGHLIN.....