

## WATER SERVICE RECORD

Name Moore Realty Trust

Service No. 183

Address 1400 14th St. S.E.

# 2991

Location Lot 69 Sta. 20+61

~~Repair~~ ~~Renewal~~ ~~New Service~~


Comm 12-18-61

Date	Material	Amount	Total	Date	Material	Amount	Total
10-20-60	Labor	4.93		11-14-61	Deposit	50.00	
	10% O.F.	.47	4.90	12-29-61	Paid	1.38	
10-20-60	3/4" Copper Tubing	.42	5.06			51.38	
1	Er. Trucking @ 3.00	3.00	5.00				
	10% O.F. @ .45	.45	32.73	10-20-60	Labor	8.55	
11/16/61	Labor	4.47		10-20-60	3/4" Copper Tubing	.42	4.90
	10% O.F.	.45	4.92	1	3/4" 6 Deep Socket	4.01	
47'	3/4" Copper Tubing @ .42		19.74	1	3/4" 6 Deep Socket	4.01	
1	3/4" x 1/2 IWH Stop & Waste		6.17	1	3/4" 6 Deep Socket	4.01	
2	3/4" 3 Part Unions @ 2.41		4.82	1	Box of Lead	4.90	
1	Er. Trucking @ 3.00		3.00			23.84	
	Previous Charge		12.73	11/16/61	1 1/2 Straight Tailpiece	50	
			51.38		1 1/2 Offset Tailpiece	50	
						24.84	

DATE \_\_\_\_\_

TOWN OF LEXINGTON — BOARD OF PUBLIC WORKS  
**WATER DIVISION**

Sketch of Service Here

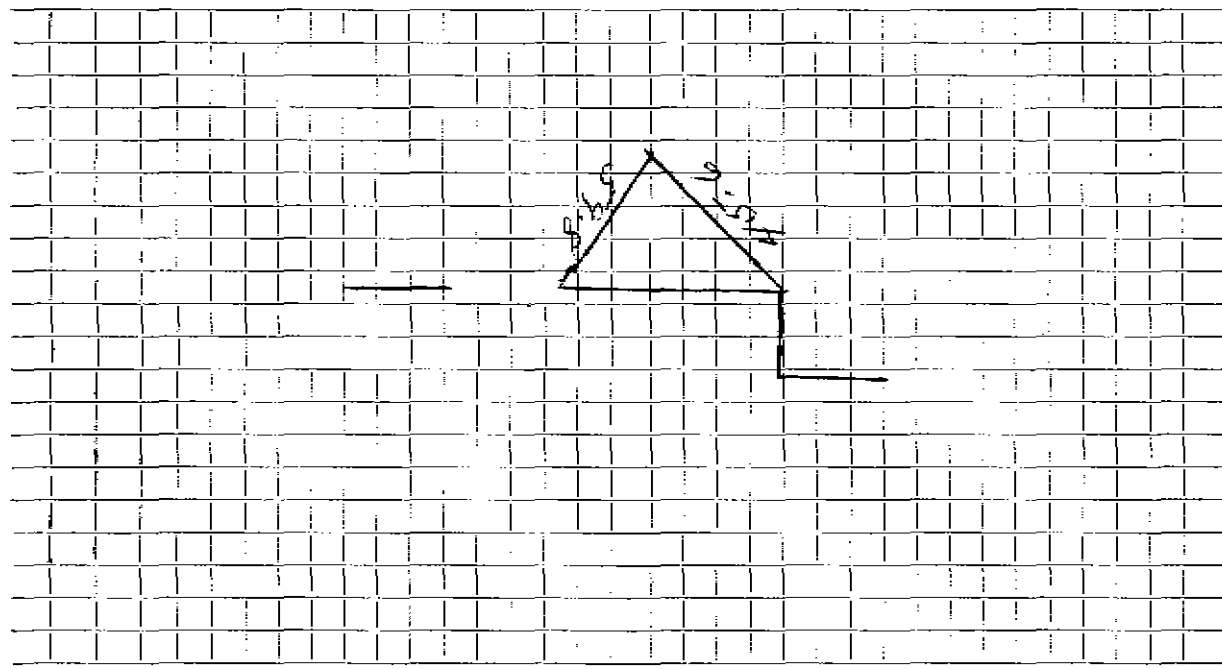

Connection made in ..... Street.      Work completed .....

Remarks: .....  
.....  
.....