




DATE 8-16-01

TOWN OF LEXINGTON — BOARD OF PUBLIC WORKS  
WATER DIVISION

Sketch of Service Here

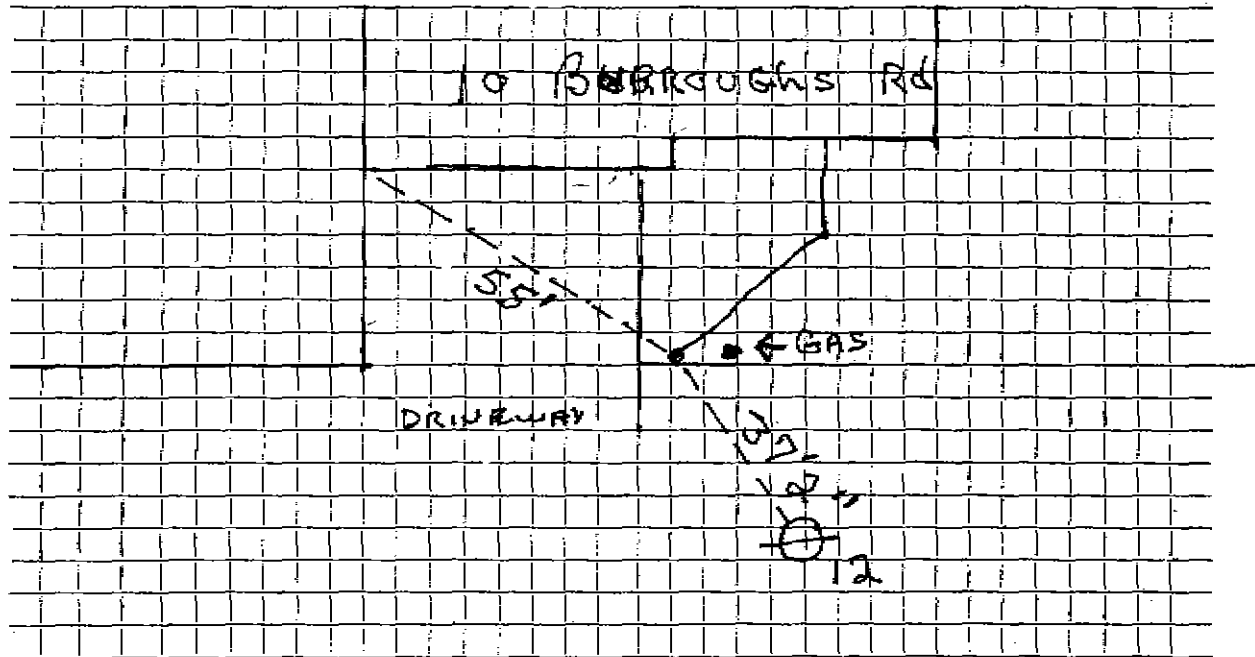

Connection made in BURROUGHS... Rd. Street.

Work completed .....

Remarks: .....

.....  
.....