

## WATER SERVICE RECORD

Name Emerson Realty Trust Company

Service No. 114

Address 11 Burroughs Road

# 2827

Location Lot #90 Sta. 14+50

~~Repair/ Renewal~~ — New Service

Comm 9-25-61


Date	Material	Amount	Total	Date		Amount
8-15-61	Labor	3.95		8-14-61	Deposit	75.00
	10% O.H.	.90	9.85	9-25-61	Refund	22.63
	62' 3/4" Copper Tubing @.42		26.04			52.37
	1 3/4" C x 3/8 I.W.E. STOP & Waste		6.17			
	1 3/4" 3 part union		2.41		NON CHARGE	
	1 Box & Rod		4.00	10-20-60	Labor	8 84
	1 Hr. Trucking @3.00		3.00		25' 3/4" Copper tubing	10 50
			52.37		1 3/4" CCorp Cock	4 91
					1 3/4" CCurb Cock	6 28
					1 Box & Rod	4 90
						35 43
				8-15-61	1 1/2 Straight tailpiece	.50
					1 1/2 Offset tailpiece	.50
						36.43

DATE \_\_\_\_\_

TOWN OF LEXINGTON — BOARD OF PUBLIC WORKS

WATER DIVISION

Sketch of Service Here

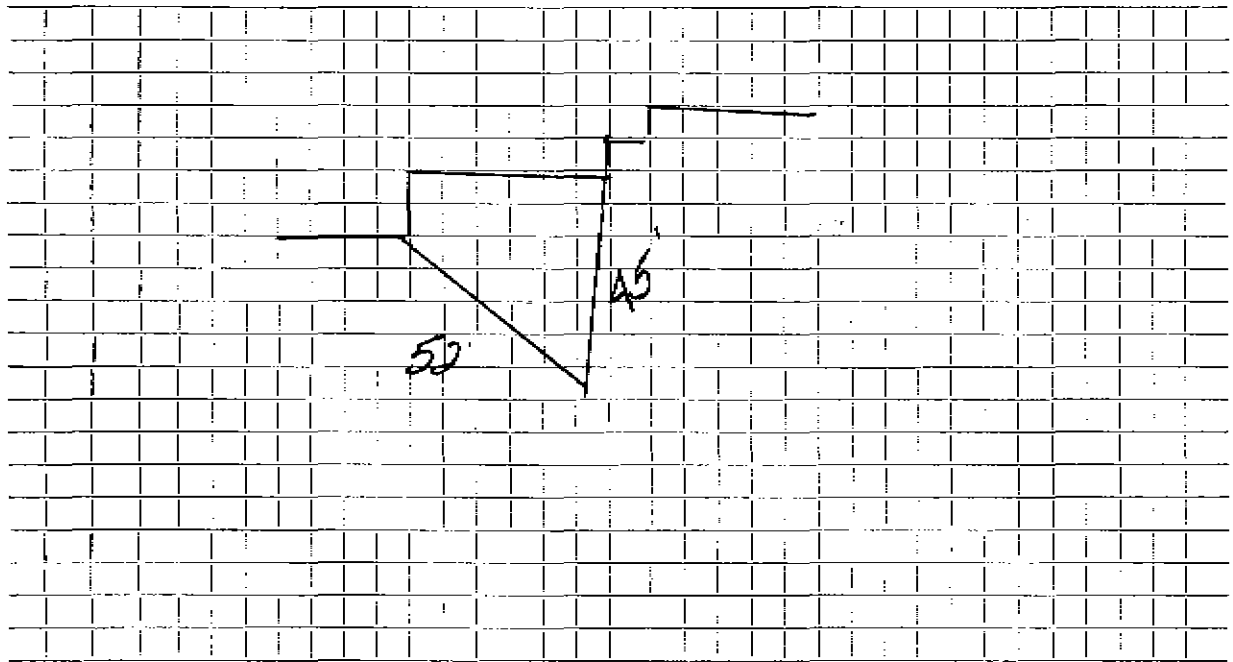

Connection made in ..... Street. Work completed .....

Remarks: .....  
.....  
.....