

WATER SERVICE RECORD

Name Emerson Realty Trust

Service No. #21

Address 15 Burroughs Road

#7615

Location Lot 89 Sta. 12+86

~~REPAIR RENEWAL~~ New Service WO #7106

Comm 6-25-62


Date	Material	Amount	Total	Date		Amount
4-26-62	Labor	4.89		4-3-62	Deposit	50.00
	10% O.H.	.49	5.38	6-25-62	Refund	3.67
70'	3/4" Copper tubing @.42		29.40			46.36
1	3/4" Cx 1/2 I.W.H. Stop & Wast.		6.17			
1	3/4" C3 Part Union		2.41		NON CHARGE	
1	Hr. Trucking @3.00		3.00	10-20-60	Labor	8.84
			46.36	25'	3/4" Copper tubing	10.50
				1	3/4" CCorp Cock	4.91
				1	3/4" C Curb Cock	6.28
				1	Box & Rod	4.90
						35.43
				1	1/2 Straight Tailpiece	.50
				1	1/2 Offset Tailpiece	.50
						36.43
	(Owner dug trench)					

DATE _____

TOWN OF LEXINGTON — BOARD OF PUBLIC WORKS

WATER DIVISION

Sketch of Service Here

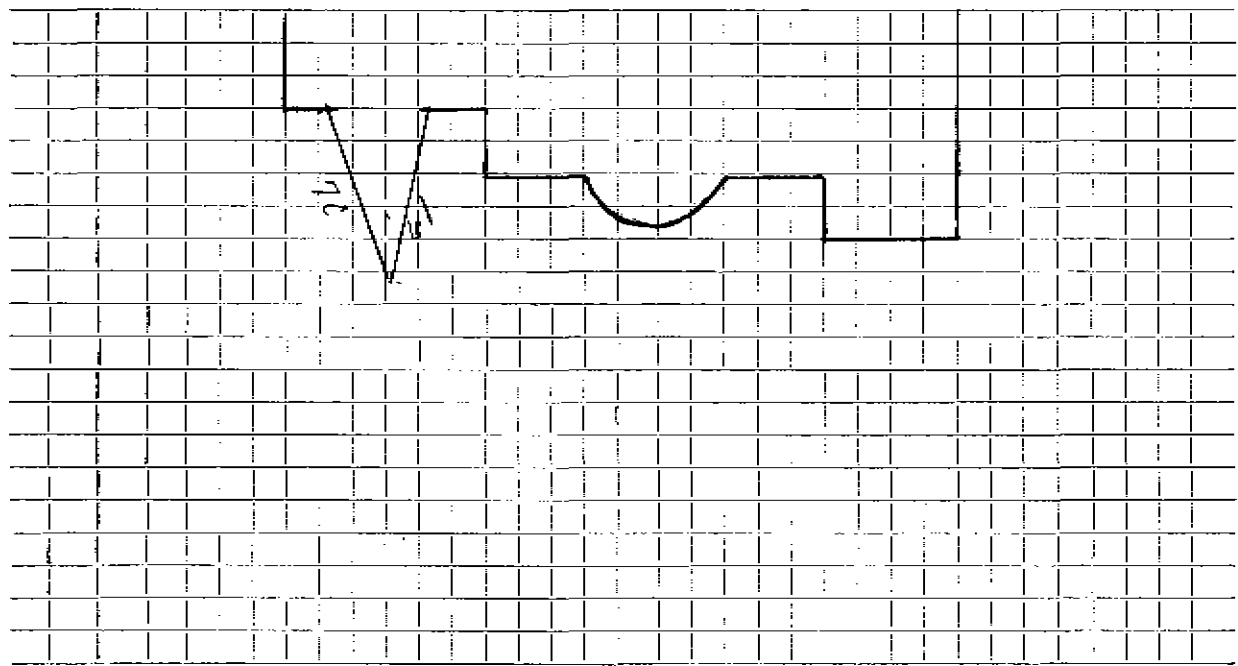

Connection made in Street. Work completed

Remarks:
.....
.....