

## WATER SERVICE RECORD

#412

Name Emerson Realty Company

Service No. 115

Address 17 Burroughs Road

Location Lot #88 Sta.11+47

~~Repair~~ ~~Renewal~~ New Service

Com in 9-25-61


Date	Material	Amount	Total	Date		Amount
8-15-61	Labor	8 95		8-14-61	Deposit	25 00
	10% C.E.	.90	9.85	9-25-61	Refund	32 04
57'	3/4" Copper Tubing	\$3.42	23.94			42 96
1	3/4" C x 1/2 I.W.H. STOP & Waste		6.17			
1	Hr. Trucking @3.00		3.00		NON CHARGE	
			42.96	10-20-60	Labor	8 84
					25' 3/4" Copper tubing	10 50
					1 3/4" C Corp Cock	4 91
					1 3/4" C Curb Cock	6 28
					1 Box & Rod	4 90
						35 43
				8-15-61	1 1/2 Straight tailpiece	.50
					1 1/2 Offset tailpiece	.50
						36.43

DATE \_\_\_\_\_

**TOWN OF LEXINGTON — BOARD OF PUBLIC WORKS**

**WATER DIVISION**

Sketch of Service Here

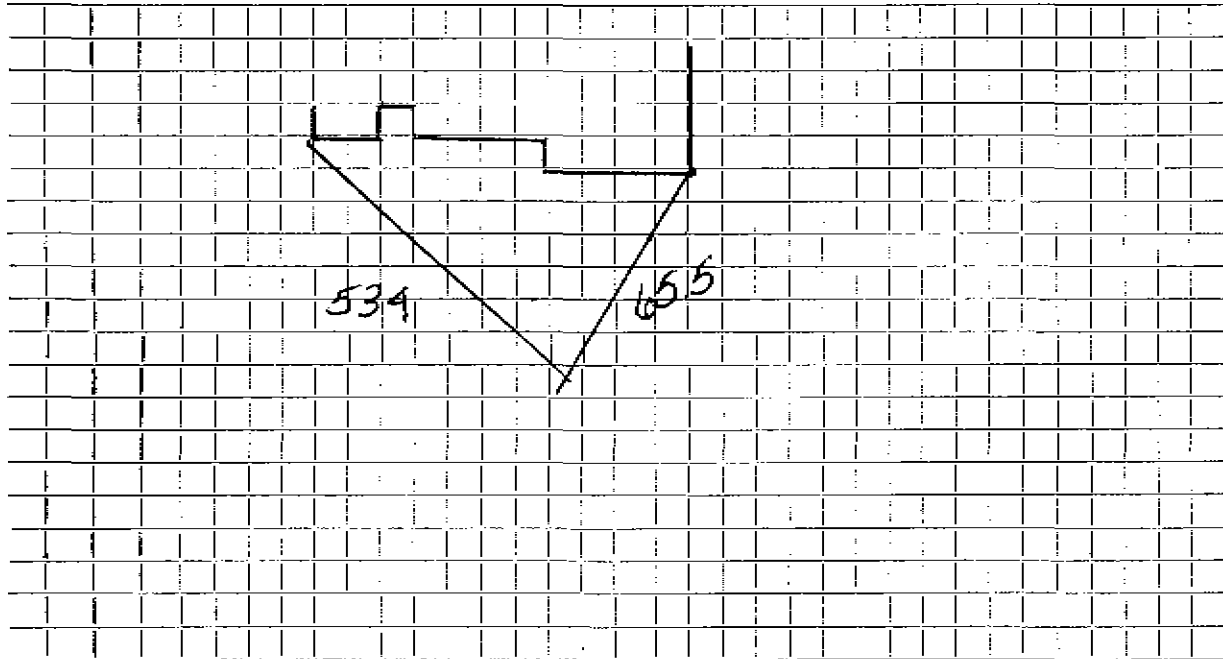

Connection made in ..... Street. Work completed .....

Remarks: .....

.....

.....